


T. 10 S., R. 41 E., W.M.

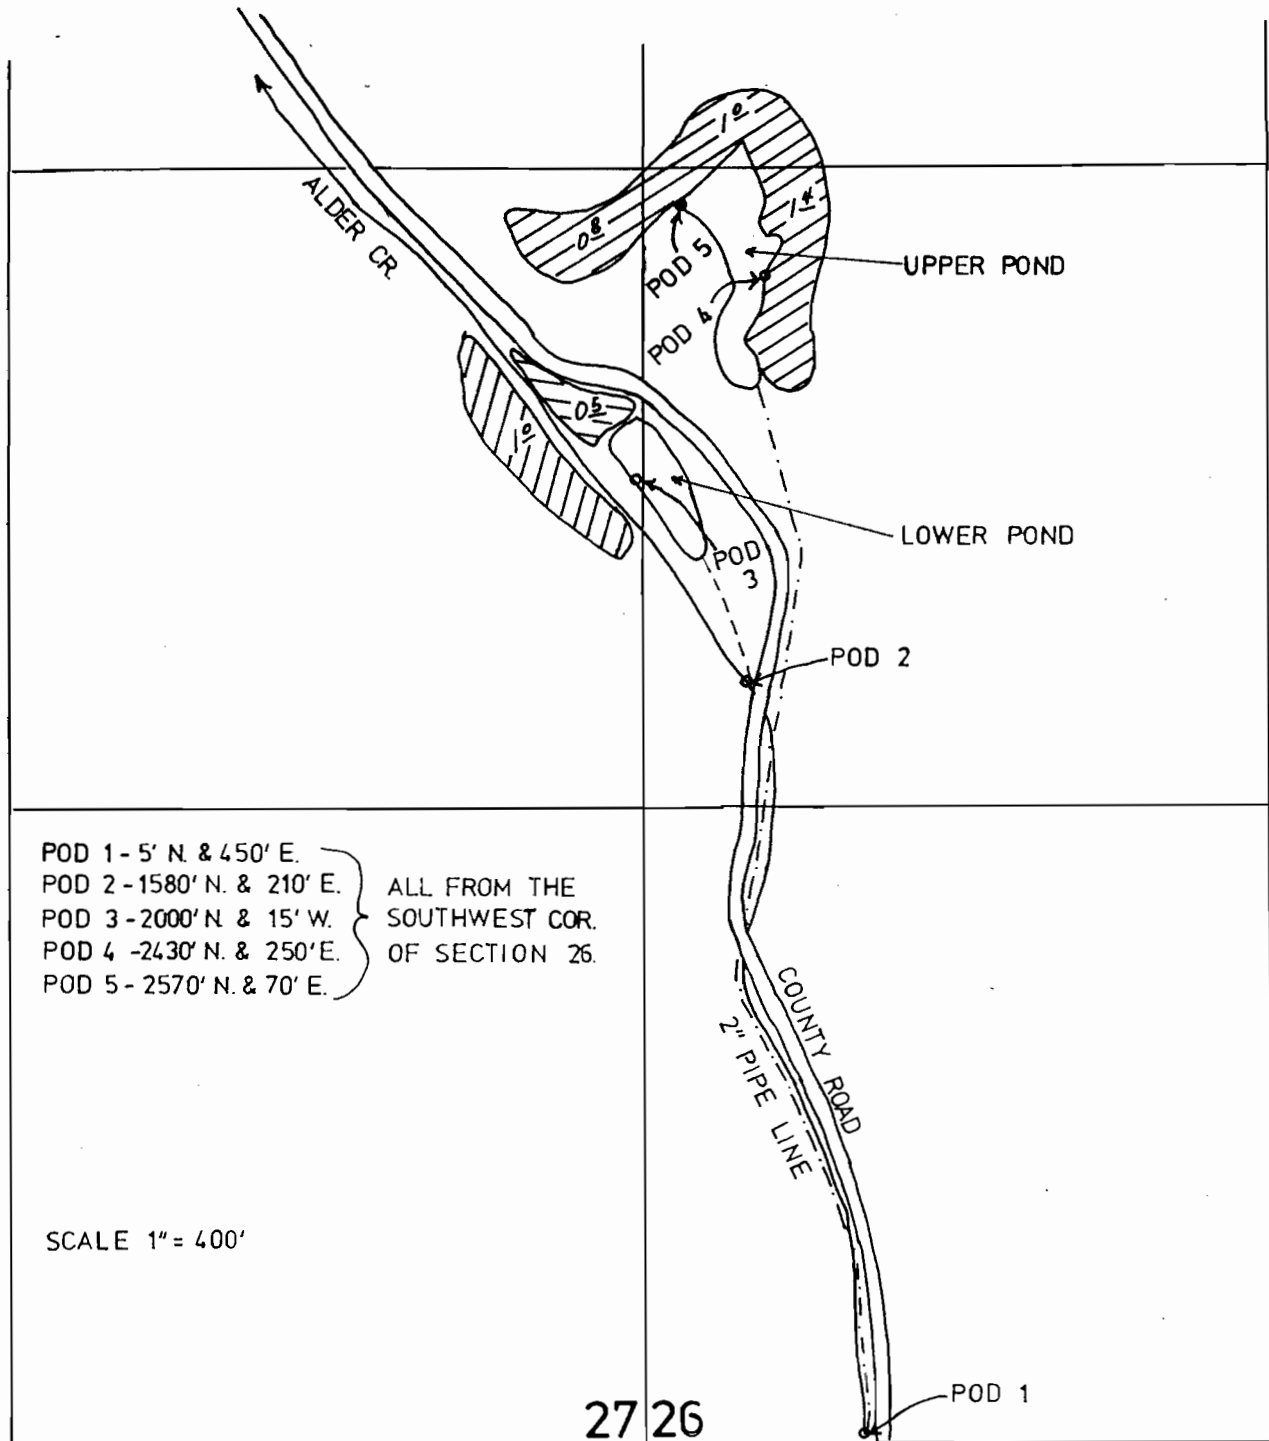

FINAL PROOF SURVEY UNDER

Application No. R-61182 Permit No. R-8308
61183 46060

IN NAME OF

SID JOHNSON

Surveyed APRIL 6, 1994, by J. MILLER

 PRIMARY, ALDER CR.
AND UPPER POND
POD'S 1, 4 & 5.

 PRIMARY, ALDER CR.
AND LOWER POND
POD'S 2 & 3.

 SUPPLEMENTAL,
LOWER POND,
POD 3.