


T. 13 S., R. 44 E., W.M.

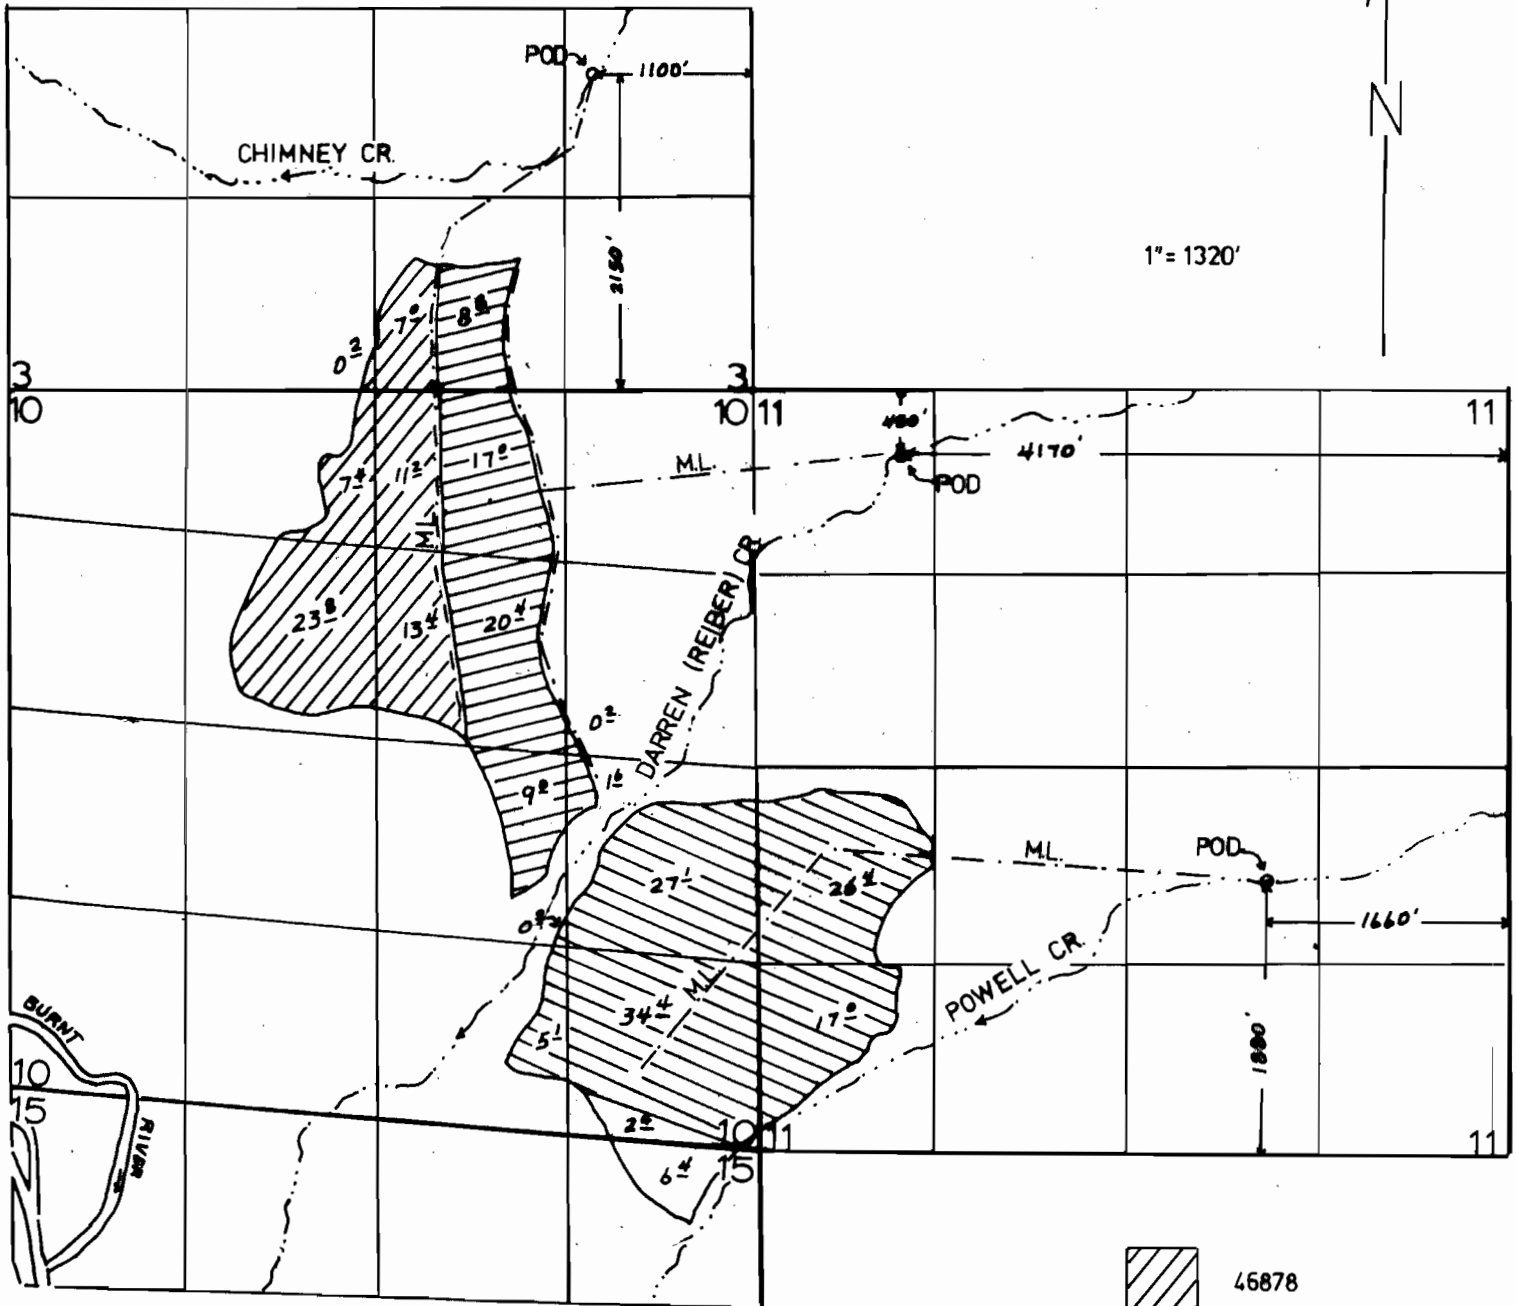

FINAL PROOF SURVEY UNDER

Application No. 63690 Permit No. 46878
65475 48229
65476 48230

IN NAME OF

IVAN B. LANGLEY

Surveyed JUNE 10, 1992, by L. MILLER