


T. 7 & 8 S., R 25 E., W.M.

RECEIVED

APR 28 2001

LAND RESOURCES DEPT.
SALE, OREGON

 P49480
 T-5703

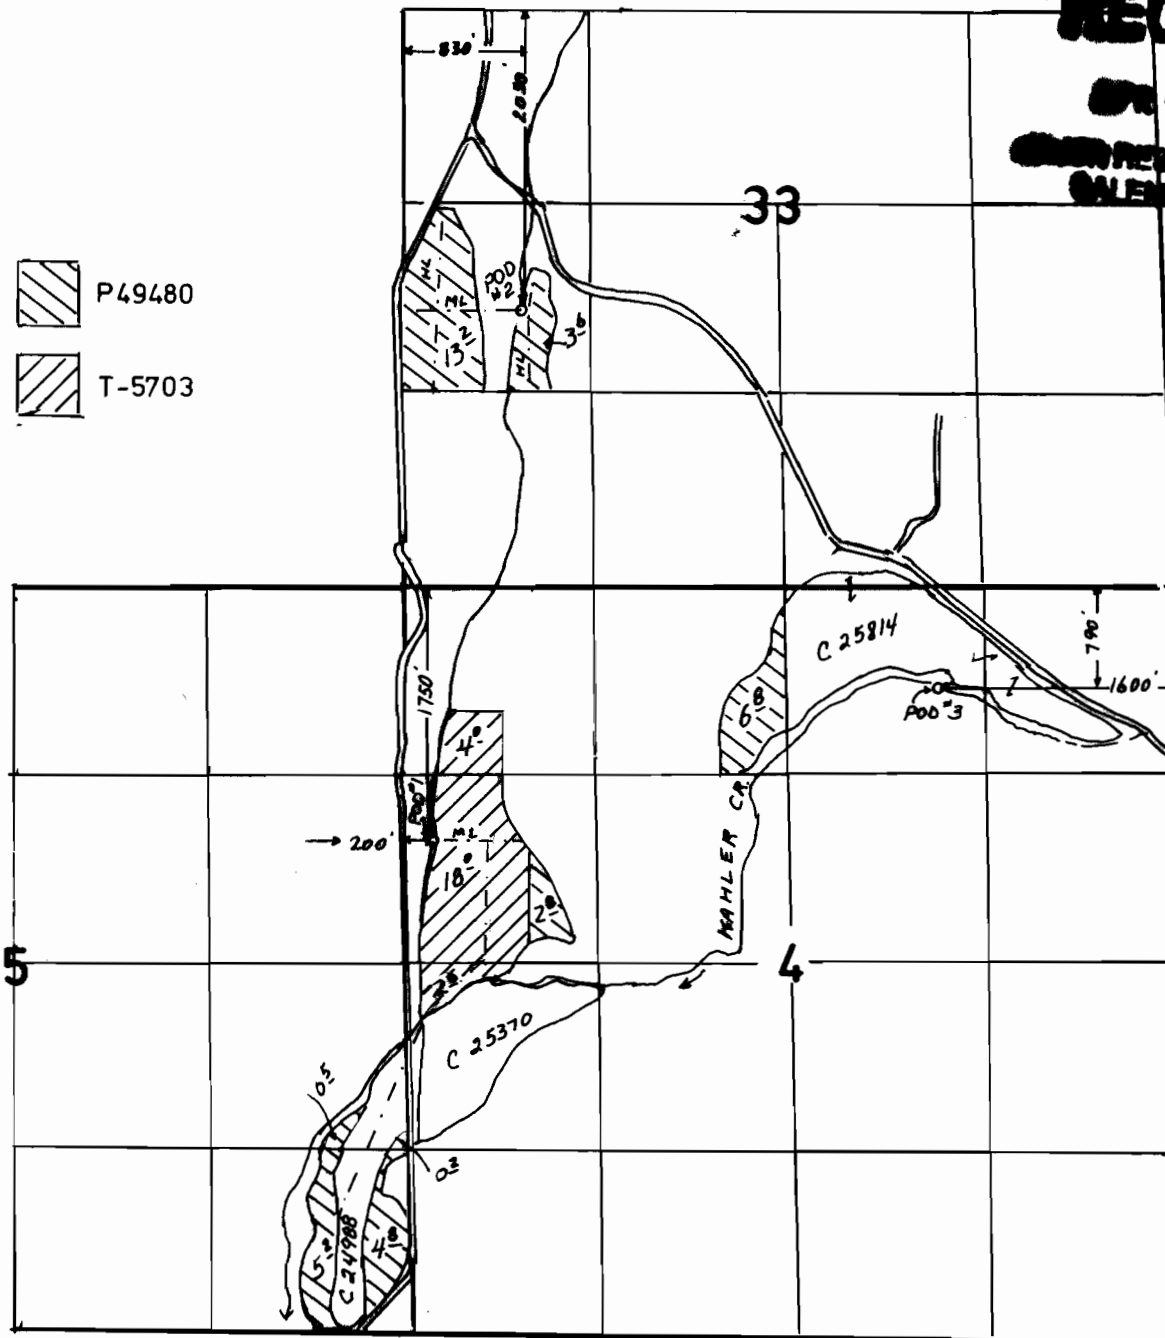

1" = 1320'

FINAL PROOF SURVEY UNDER

TRANSFER NO.5703

Application No. 68549... Permit No. 49480.....
IN NAME OF

.....ROBERT W. STRAUB.....

Surveyed 6-13-2000, by J. MILLER.....