


Application No. R-57269
Permit No. R 7698

T38S R11½E

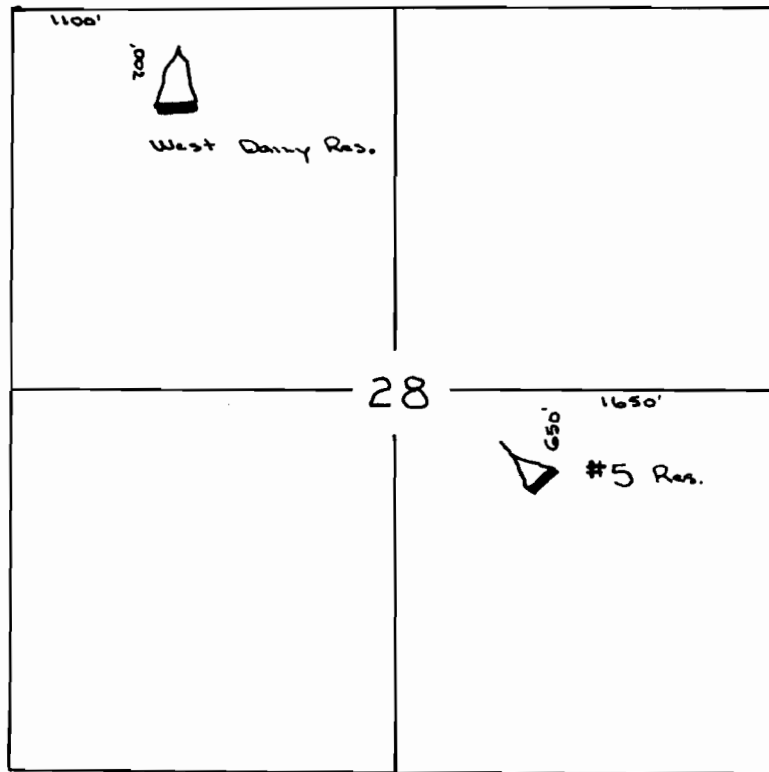

THIS MAP PREPARED BY:
Donald E. Venable
FROM INFORMATION FURNISHED BY
THE APPLICANT.

Biaggi & Venable by T. Venable

Star Route

Dairy, Oregon 97625

RECEIVED
MAY 1968