


Application No. ^R 57270
Permit No. R 7699

T38S R11½E

RECEIVED
APR 7 1978
WATER RESOURCES DEPT.
SALEM, OREGON

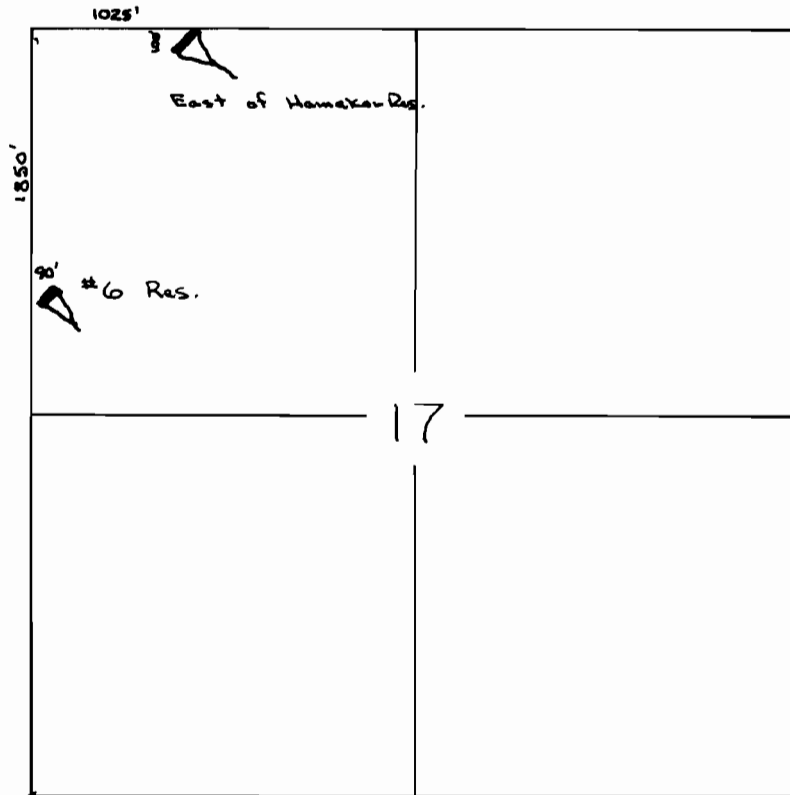

David E. Trauer

Biaggi & Venable by T. Venable

Star Route

Dairy, Oregon 97625