


Application No. R-57271
Permit No. R 7700

T38S R11½E

RECEIVED

APR 7 1978

**WATER RESOURCES DEPT.
SALEM, OREGON**

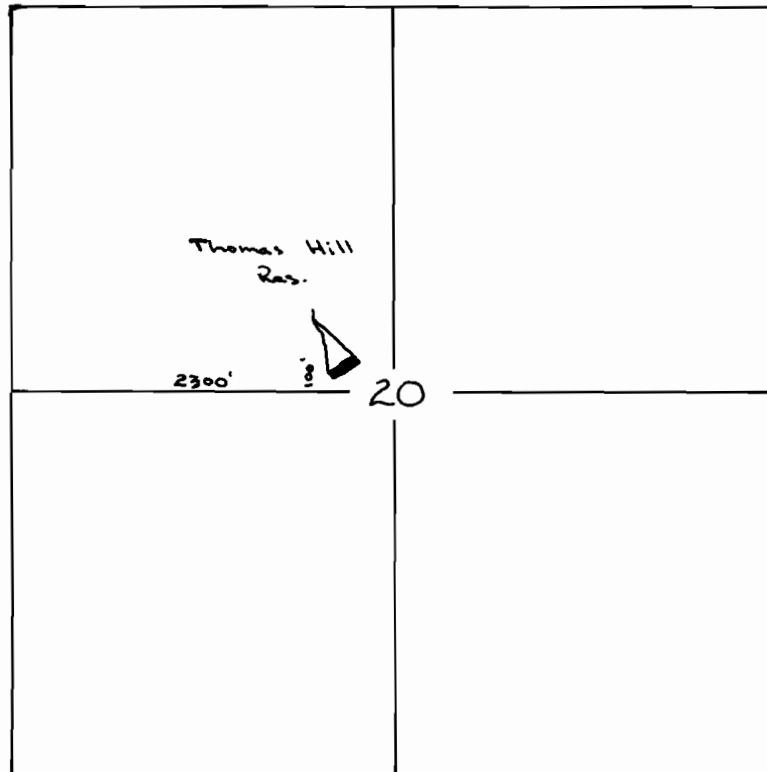

Biaggi & Uenable by T. Uenable

Star Route

Dairy, Oregon 97625

David S. Kramer