


J-11464
G10582

Willamette River

LWAKIE & VICINITY



SCALE: 4 inches = 1 mile

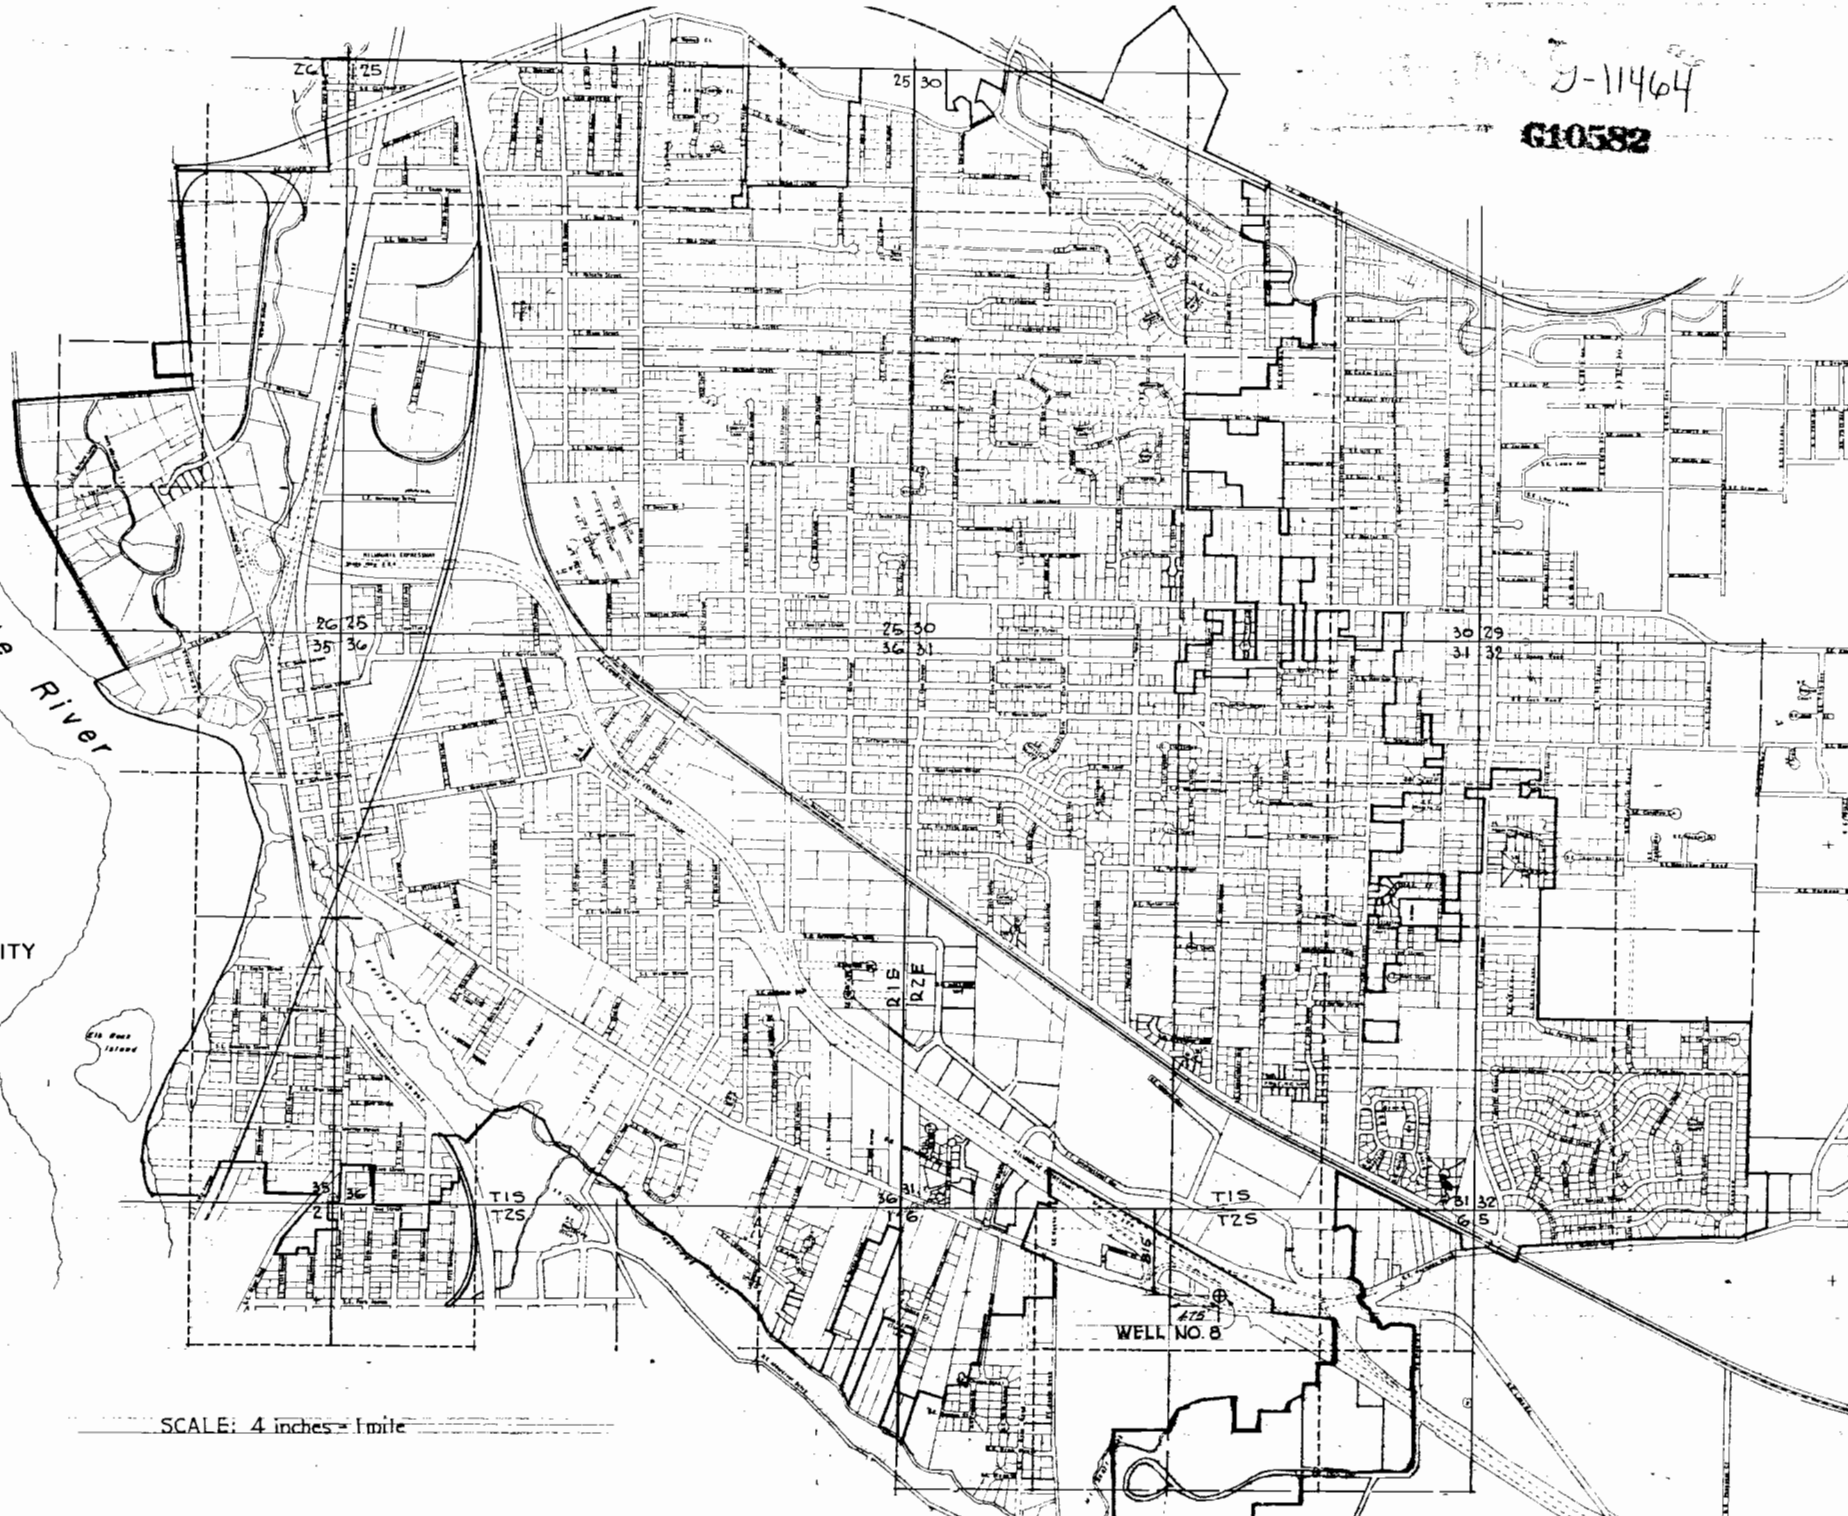

WELL NO. 8