


T. 1 N., R. 3 E., W.M.

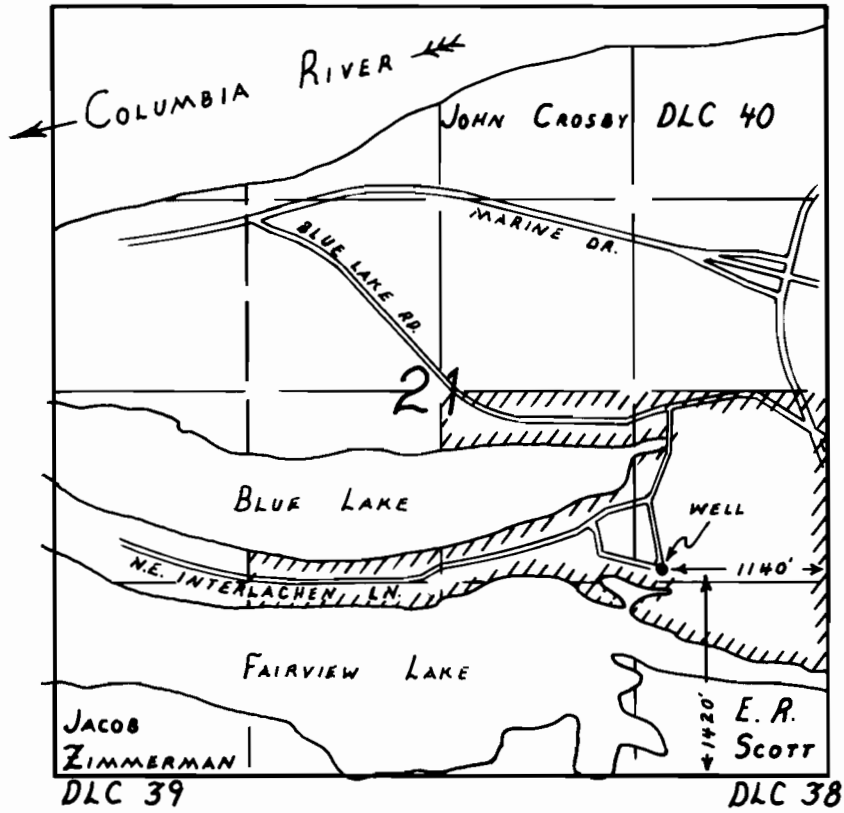

FINAL PROOF SURVEY

UNDER

Application No. G-8890 Permit No. G-8292

IN NAME OF

Interlachen, Incorporated

Surveyed August 17, 1993, by R.W. Klassen