


RECEIVED

T 3 S, R 46 E, W. M.

44 1981
WATER RESOURCES DEPT
OREGON

scale: 1" = 660'

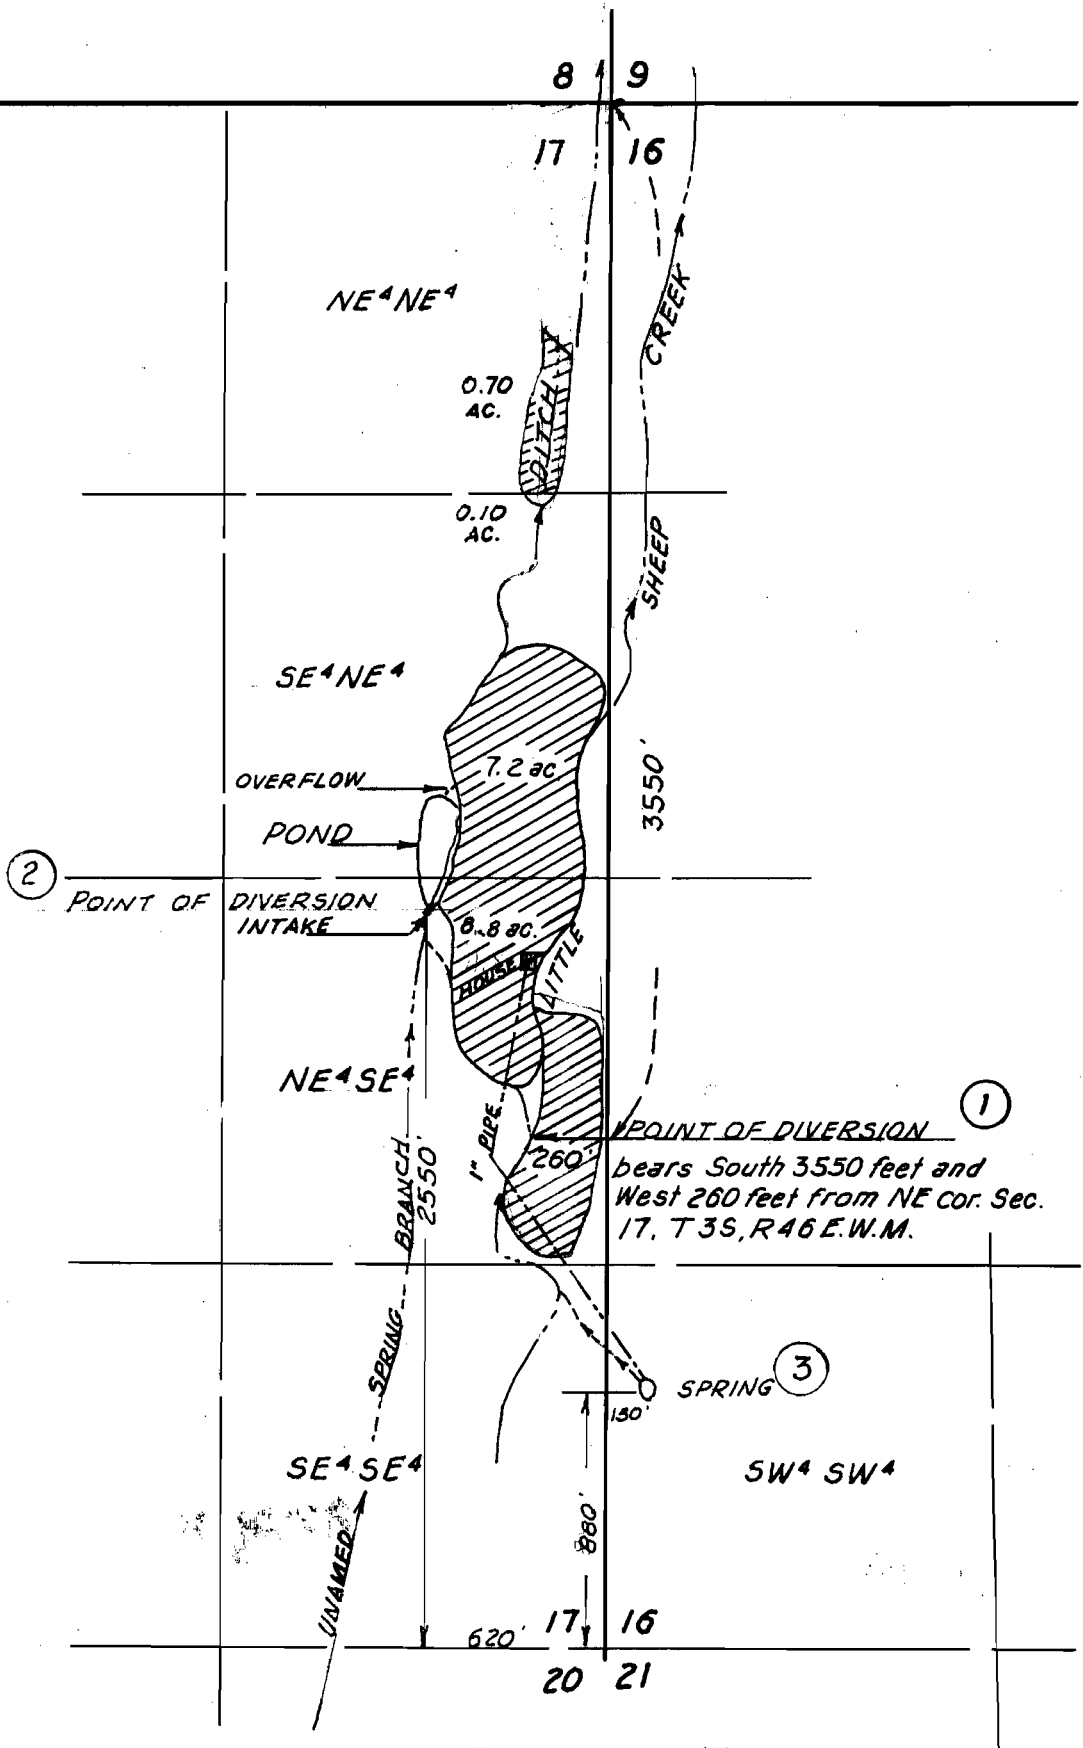

Prepared for: Johnnie Johnson
By: Verne H. Russell - PLS 427
Date: October 8, 1979

R-61177
R 8322

Application No. 61178
Permit No. 46154