


T. 1 N., R. 38 E., W.M.

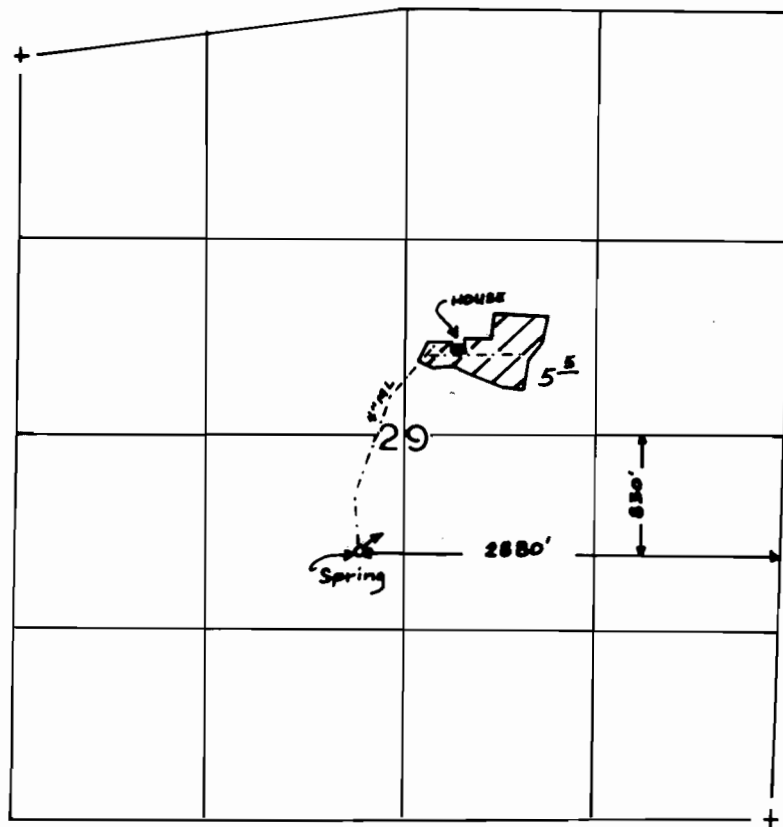

1" = 1320'

FINAL PROOF SURVEY
UNDER

Application No. 60431 Permit No. 45837
IN NAME OF

HANS W. GROEGER, M.D. AND RUTH M. GROEGER

Surveyed 7-10, 1991, by J. MILLER