


T. 2 N., R. 43 E., W. M.

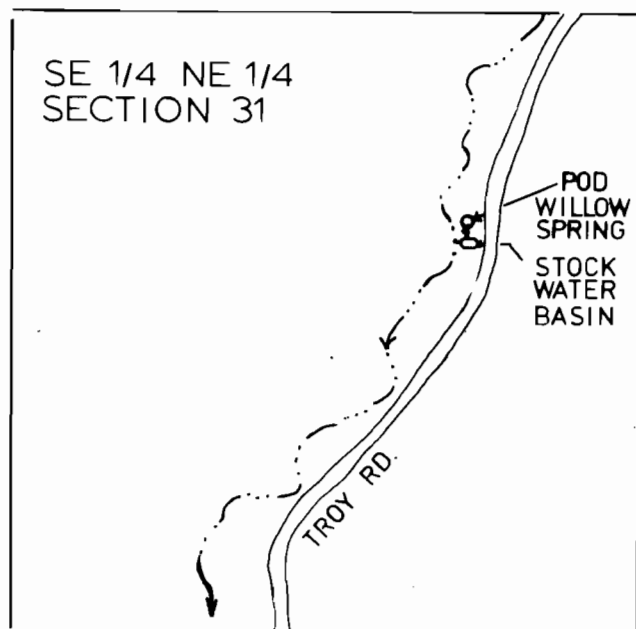

1" = 400'

POD - 850' N. AND 350' E. OF E. 1/4 COR. SEC. 31

**FINAL PROOF SURVEY
UNDER**

**Application No. 51318.... Permit No. 38747.....
IN NAME OF**

.....WILLOW CREEK RANCH.....

Surveyed 7-13..... 1994., by J. MILLER.....