


T. 2N. R. 48E., W.M.

N
↑
1"=1320'

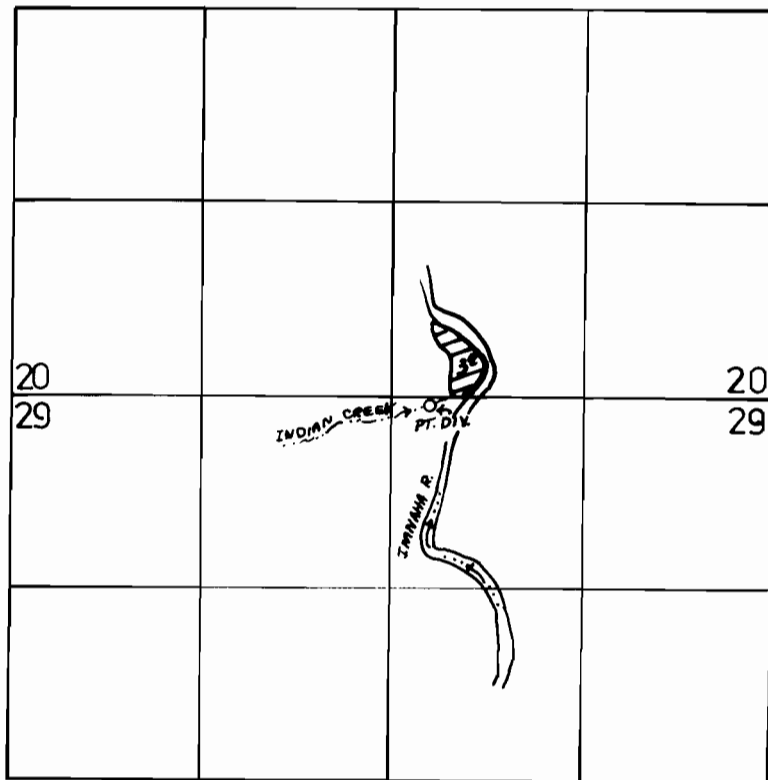

POD located 60 feet South and 260 feet East
from the N 1/4 Corner Section 29.

FINAL PROOF SURVEY UNDER

Application No. 68956 Permit No. 49967
IN NAME OF

SUSIE LEWIS (LOVELL)

Surveyed 10-6-1990, by K. KEMP

Drafted 4-7-92 gm