


T. 15 S., R. 35 1/2 E., W.M.

RECEIVED

JUL - 1 1993

WATER RESOURCES DEPT.
SALEM, OREGON

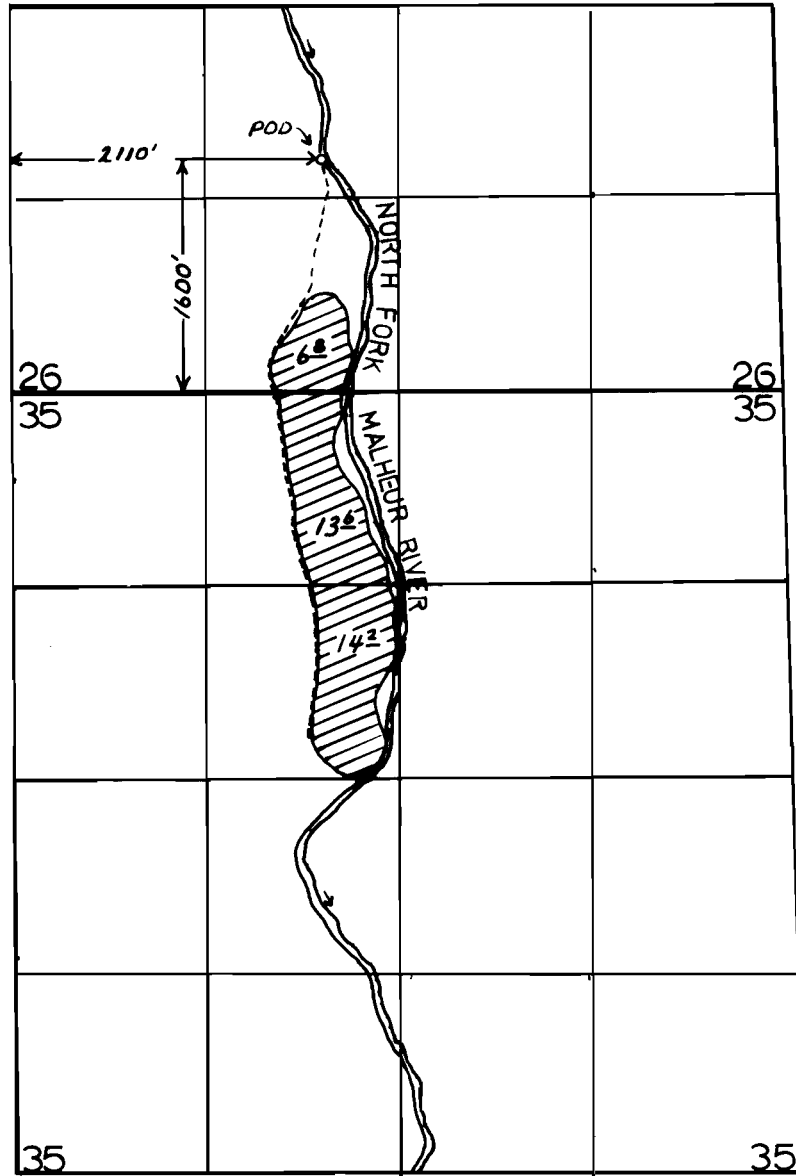

FINAL PROOF SURVEY

UNDER

Application No. 53587 Permit No. 40093

IN NAME OF

MALHEUR NATIONAL FOREST

Surveyed 9-5, 1990, by K. KEMP

Drafted 6-4-93 J.M. 41023-279-179R