


T. 15 S., R 35 ½ E., W. M.

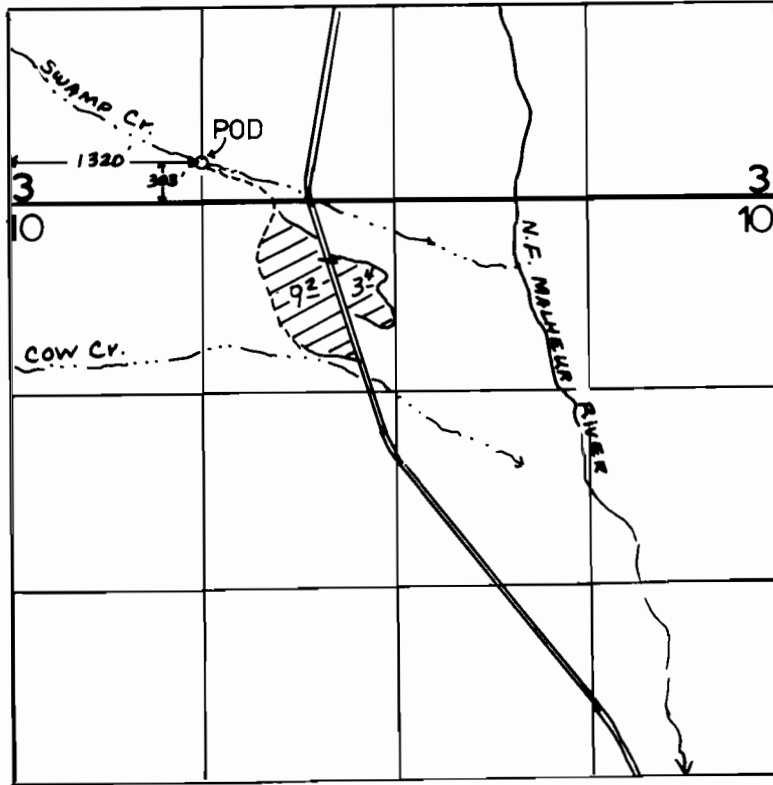

RECEIVED

AUG 30 2001

WATER RESOURCES DEPT
SALEM, OREGON

**FINAL PROOF SURVEY
UNDER**

Application No. 53586... Permit No. 40092.....
IN NAME OF

U.S.D.A. FOREST SERVICE - MALHEUR N.F.

Surveyed 7-17..... 2000, by J. MILLER.....