


T. 3 S., R. 38 E., W.M.

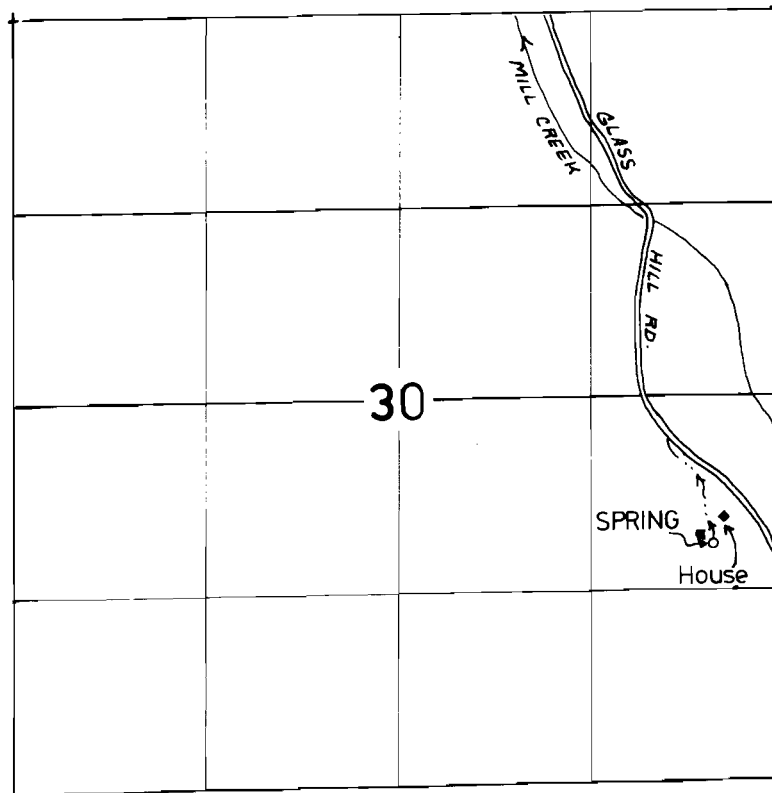

SPRING POD 1050' S. AND 500' W. FROM THE E 1/4 COR.,
SECTION 30.

FINAL PROOF SURVEY

UNDER

Application No. 63203 Permit No. 46976
IN NAME OF

ANN ESKRIDGE

Surveyed 7-7, 1993, by J. MILLER