


T. 15 S., R. 42 E., W.M.

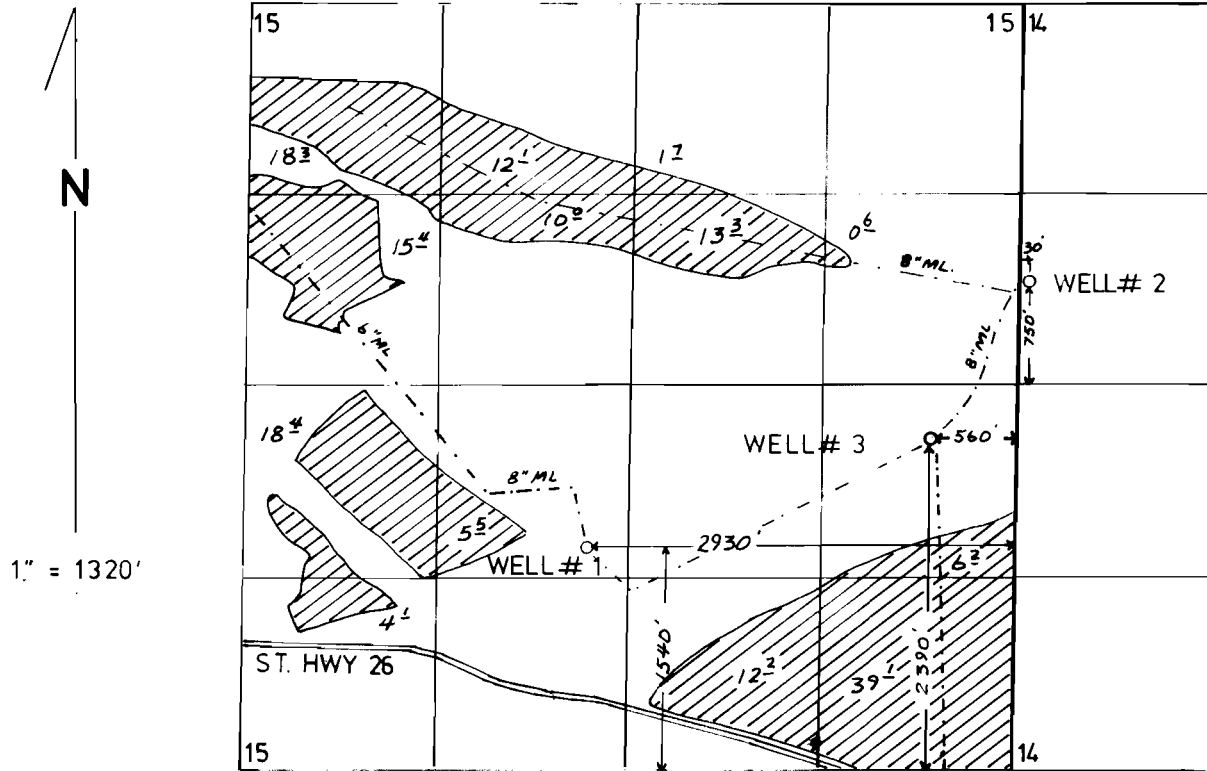

FINAL PROOF SURVEY

UNDER

Application No. G-11505 Permit No. G-10897
IN NAME OF

DAVID J. MOODY

Surveyed 8-26, 1993, by J. MILLER