


T. 1 N. & 1 S., R. 48 E., W.M.

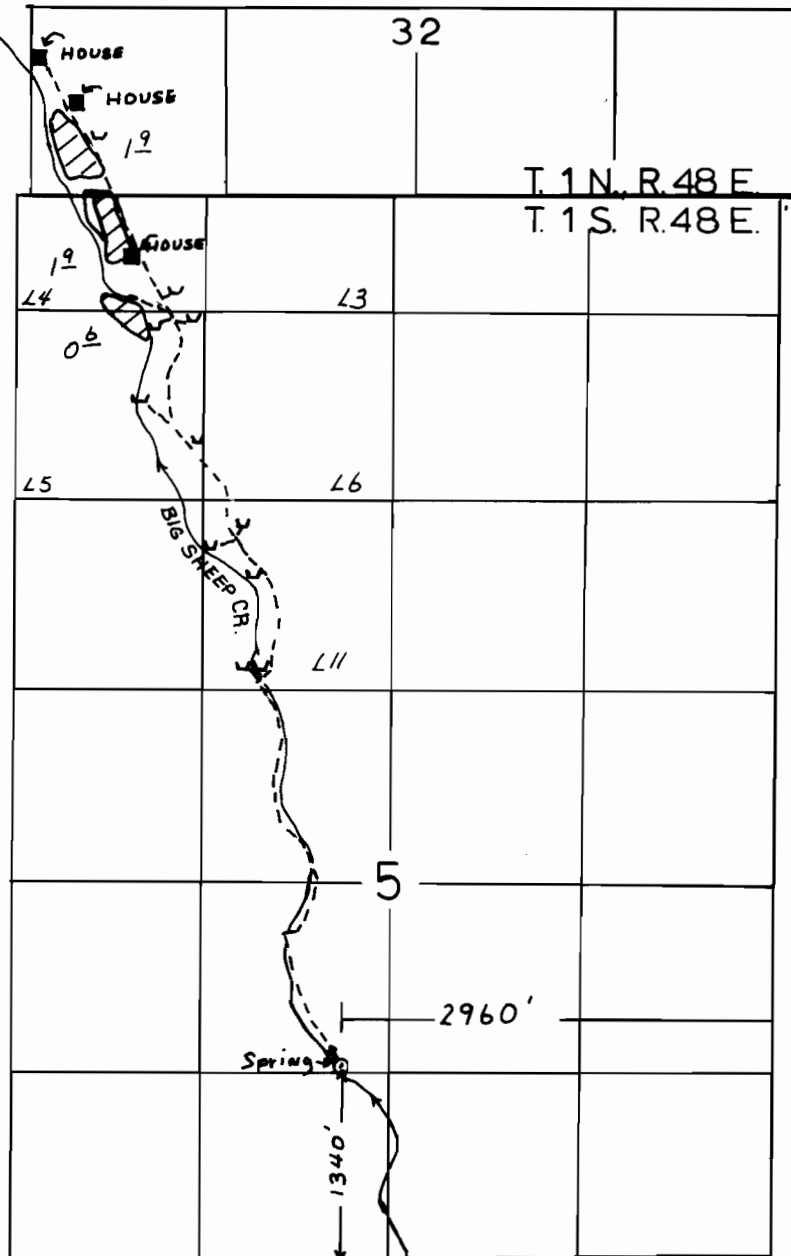

1" = 1320'

✓ stock tank

----- pipe line

FINAL PROOF SURVEY

UNDER

Application No. 68631 Permit No. 49695
IN NAME OF

H. A. BORGERDING

Surveyed 10-5, 1990, by K. KEMP

RECEIVED

WATER RESOURCES DIV.
DALEM, OREGON