


T. 13 S., R. 44 E., W.M.

RECEIVED
FEB - 2 1993
WATER RESOURCES DEPT.
SALEM, OREGON

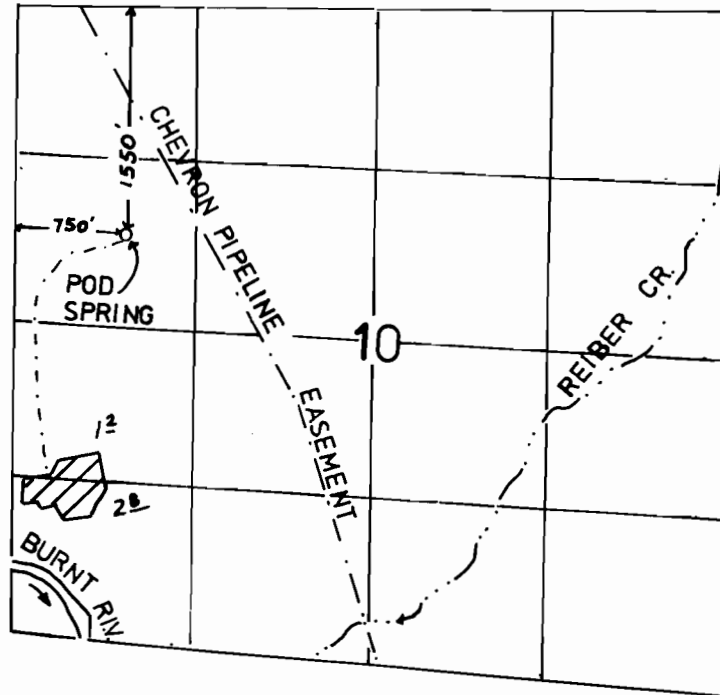

1" = 1320'

FINAL PROOF SURVEY

UNDER

Application No. 65566 Permit No. 47991
IN NAME OF

EARL V. AND BONNIE LANGLEY

Surveyed JUNE 11, 1992, by J. MILLER