TOWNSHIP 15 SOUTH, RANGE 46 EAST, W.M.

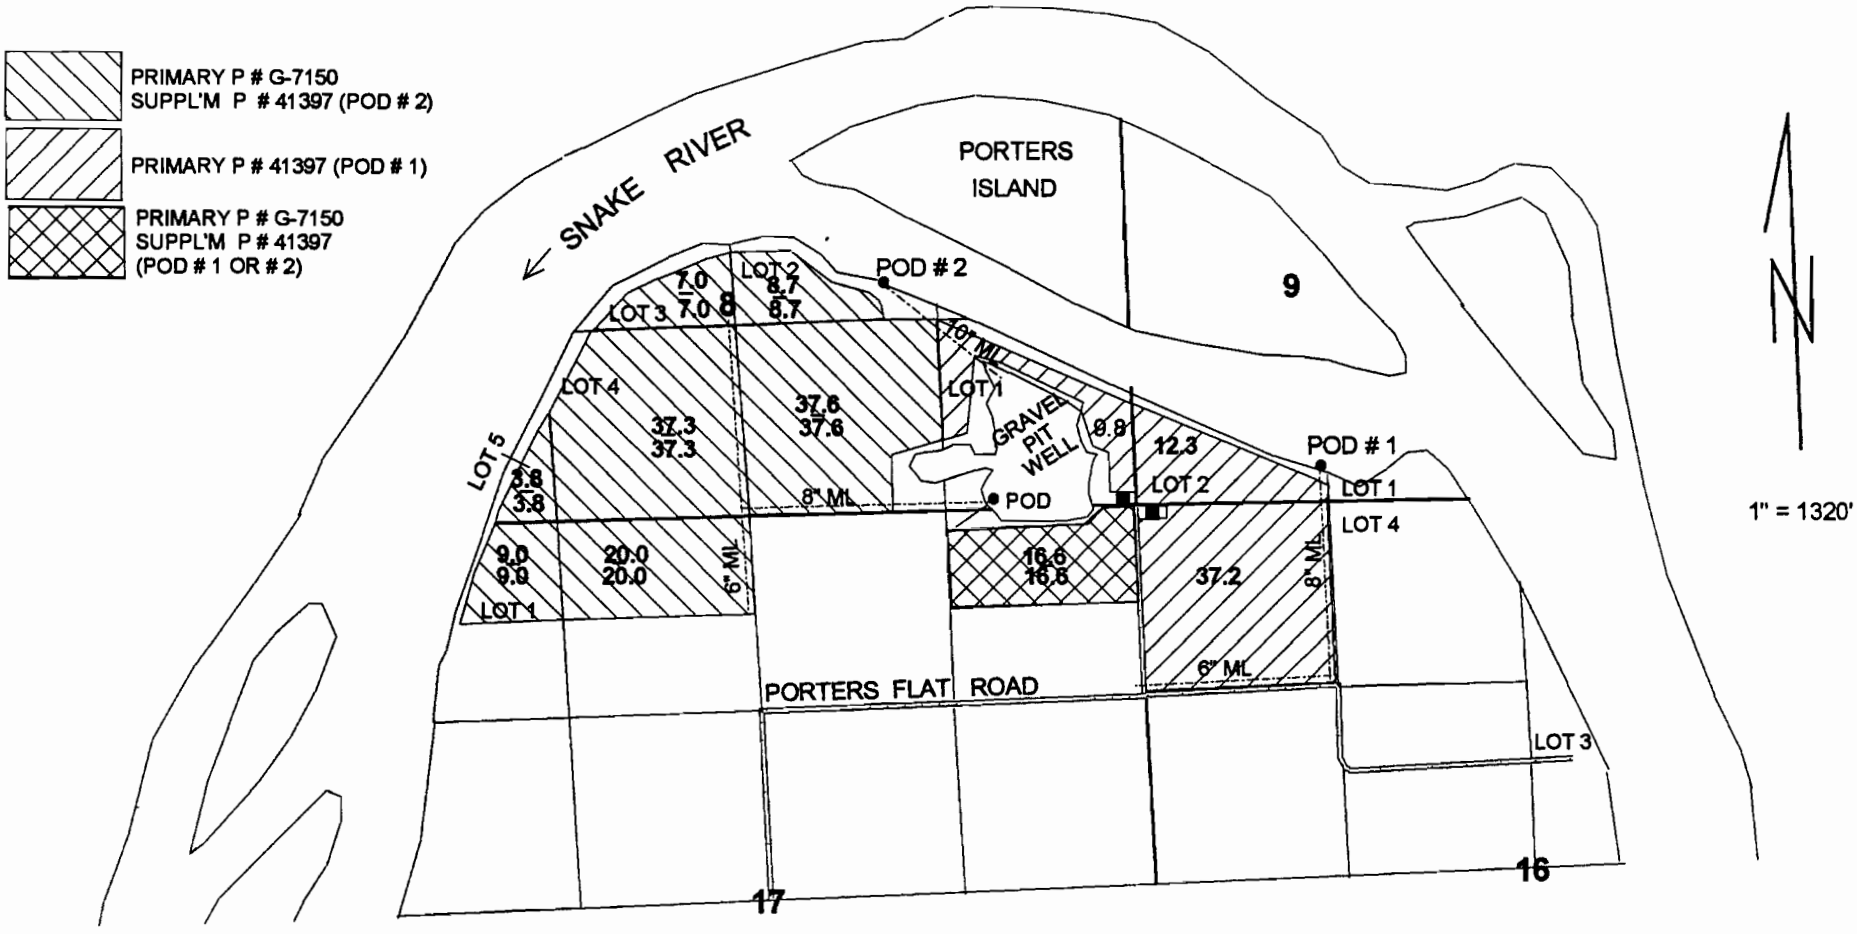

POD # 1 - SNAKE RIVER DIVERSION - 230' NORTH AND 1280' EAST OF THE SW CORNER, SECTION 9.

POD # 2 - SNAKE RIVER DIVERSION - 1570' NORTH AND 1680' WEST OF THE SE CORNER, SECTION 8.

POD - GRAVEL PIT WELL - 70' NORTH AND 900' WEST OF THE SE CORNER, SECTION 8.

FINAL PROOF SURVEY

UNDER

Application No. 55149 Permit No. 41397

G-7658 G-7150

IN THE NAME OF

Surveyed: July 31, 2002 by: J. Miller

RECEIVED
APR 03 2003
WATER RESOURCES DEPT.
SALEM, OREGON

GPS AND 1994 SERIES AERIAL JM 3-06-2003