


8671

SURVEY IN _____ SEC. _____ TWP. _____ RANGE _____ EAST W. M.
COOPER SPUR RECREATION UNIT
MT. HOOD NATIONAL FOREST
FOR Post #22- American Legion DATE 8/21/28

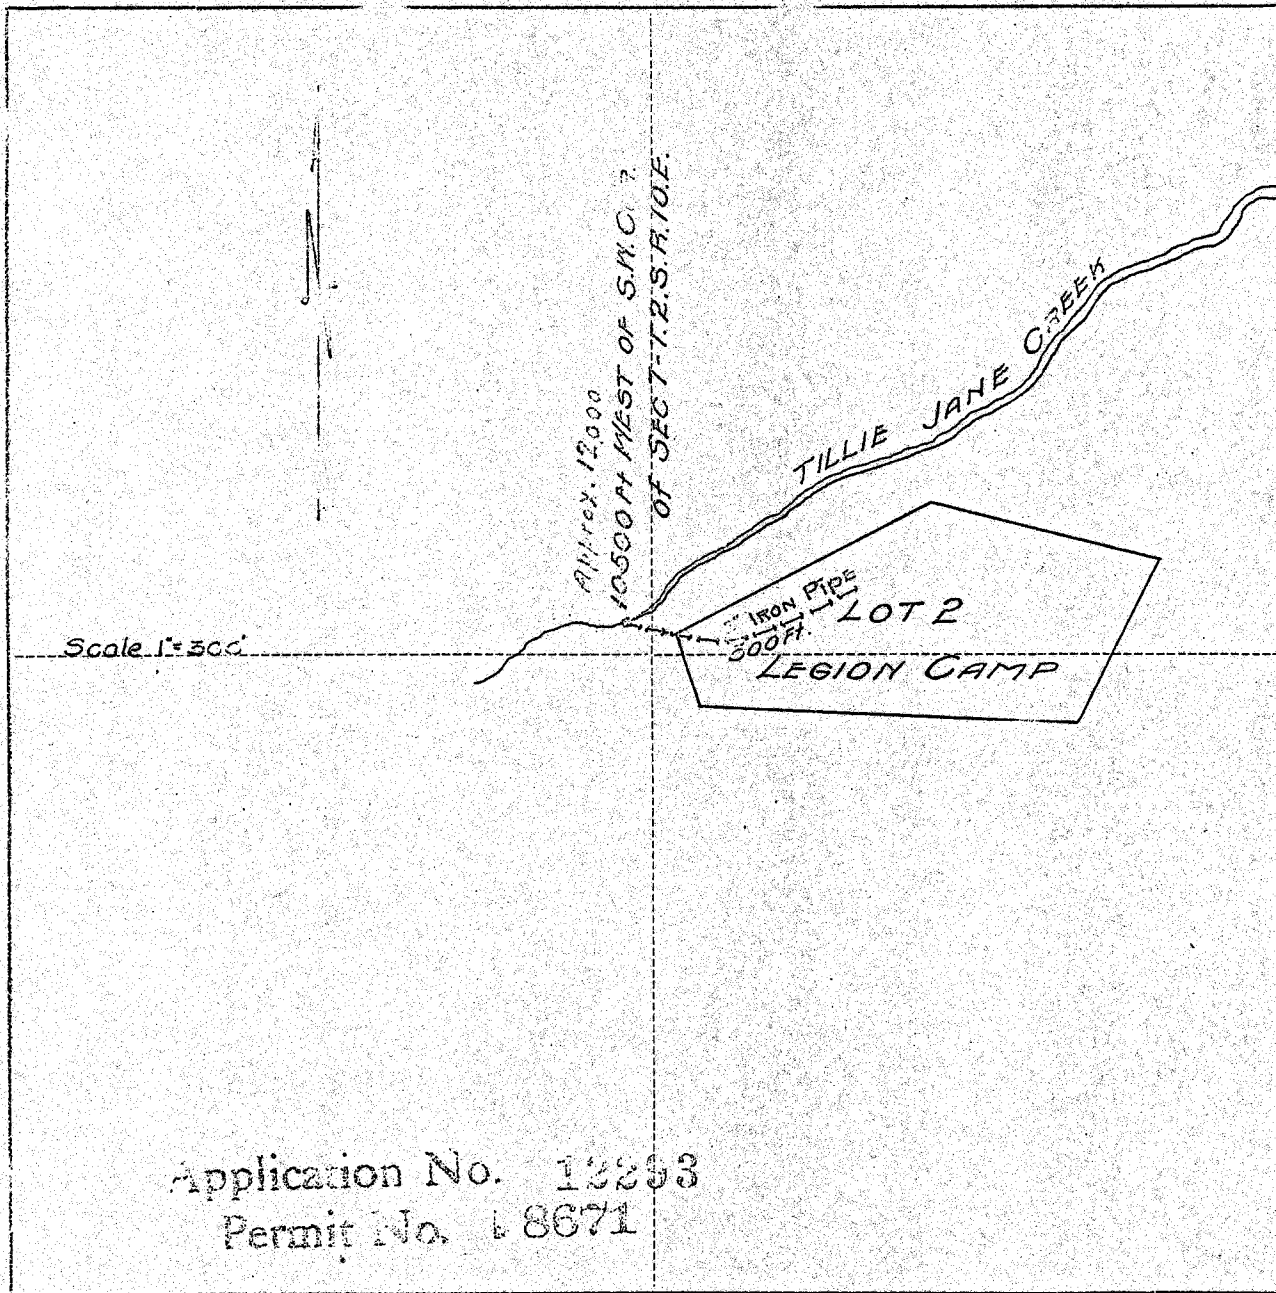

I do hereby certify that this sketch was made from notes taken during an actual survey made by me on August 21 - 1928, and that it correctly represents field work of said survey.

C. M. Hurlburt.

County Surveyor
Hood River County, Oregon

Helpers _____