


TOWNSHIP 7 SOUTH, RANGE 38 EAST, W. M.

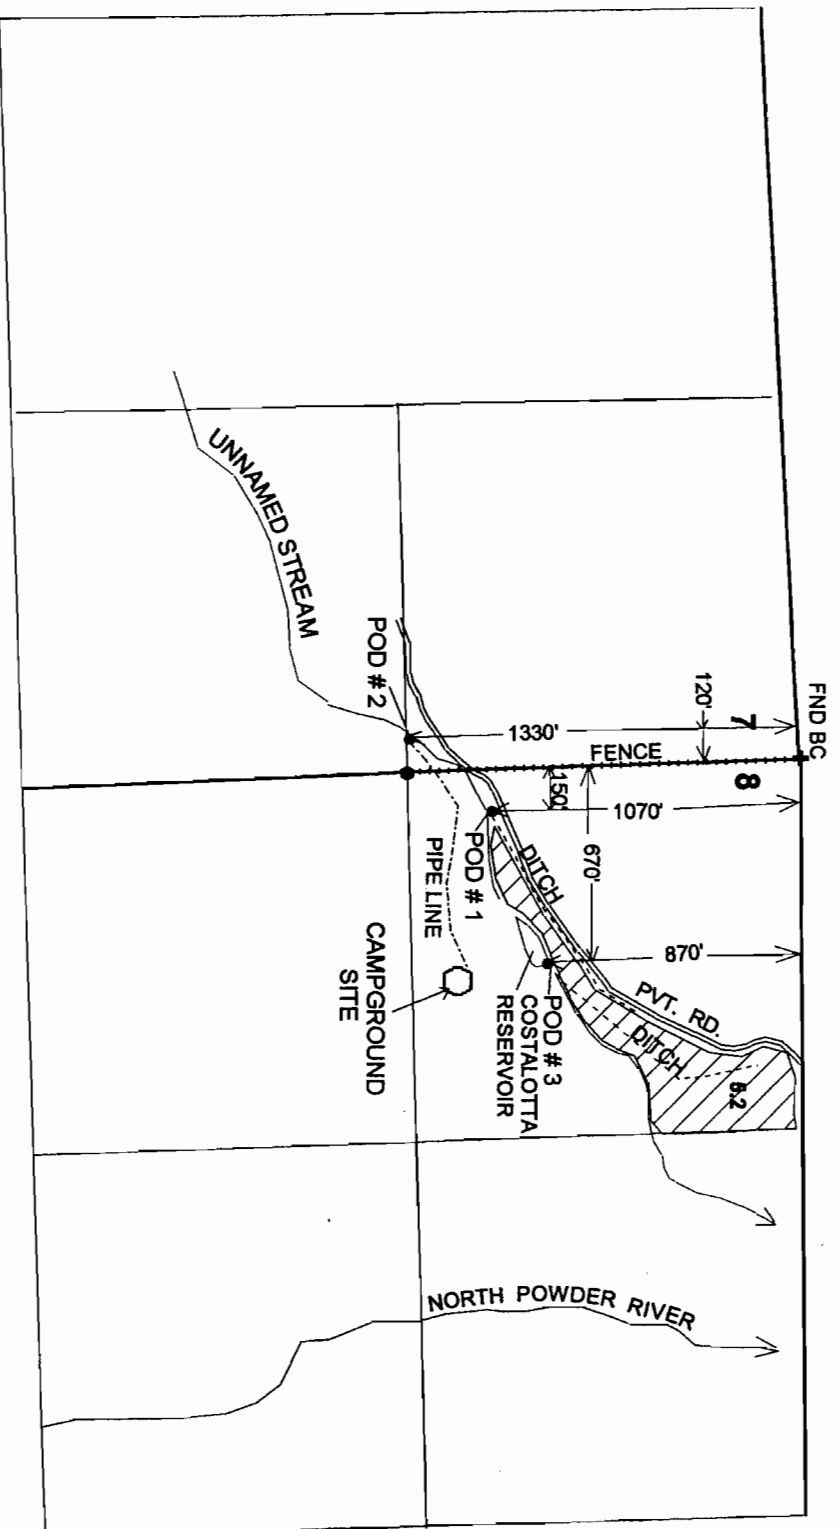

FINAL PROOF SURVEY

UNDER

Application R-63763 Permit R-8551
63758 47279

IN THE NAME OF
ROGER W. SMITH

Surveyed: July 8, 2002 by: J. Miller

RECEIVED

FEB 03 2003

WATER RESOURCES DEPT.
SALEM, OREGON