


T. 8 S., R. 45 E., W.M.

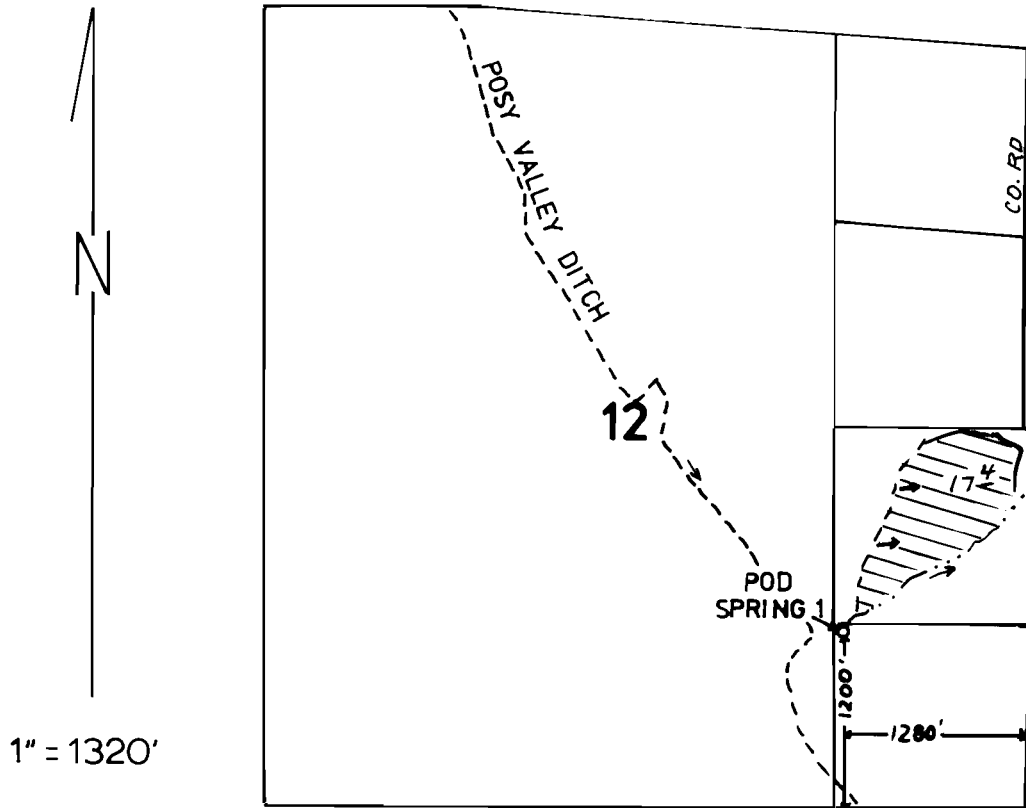

FINAL PROOF SURVEY

UNDER

Application No. 57787 Permit No. 43778
IN NAME OF

JOSEPH I. PINAIRE

Surveyed 9-12 2001, by J. MILLER