


TOWNSHIP 10 SOUTH, RANGE 39 EAST, W.M.

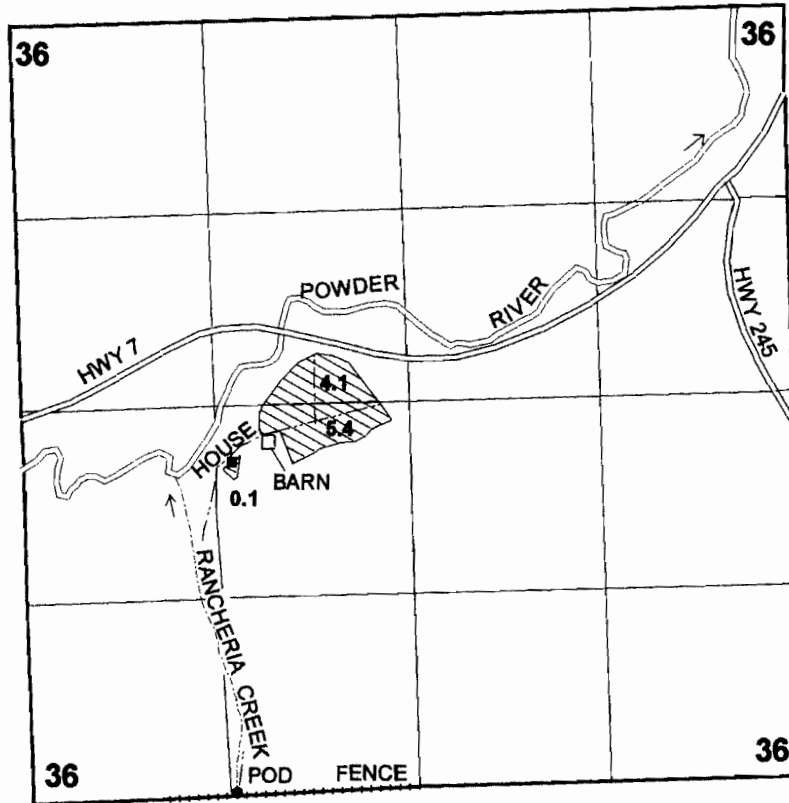

1" = 1320'

POD - 10 FEET NORTH AND 20 FEET EAST OF THE SOUTHWEST CORNER OF THE SE 1/4 SW 1/4 OF SECTION 36.

**FINAL PROOF SURVEY
UNDER**

Application No. 67442 Permit No. 48197
IN THE NAME OF
THOMAS AND JANET VAN DIEPEN
Surveyed: June 13, 2001 by: J. Miller

RECEIVED

MAR 03 2003

WATER RESOURCES DEPT.
SALEM, OREGON