



T. 19 & 20 S., R. 44 E., W. M.

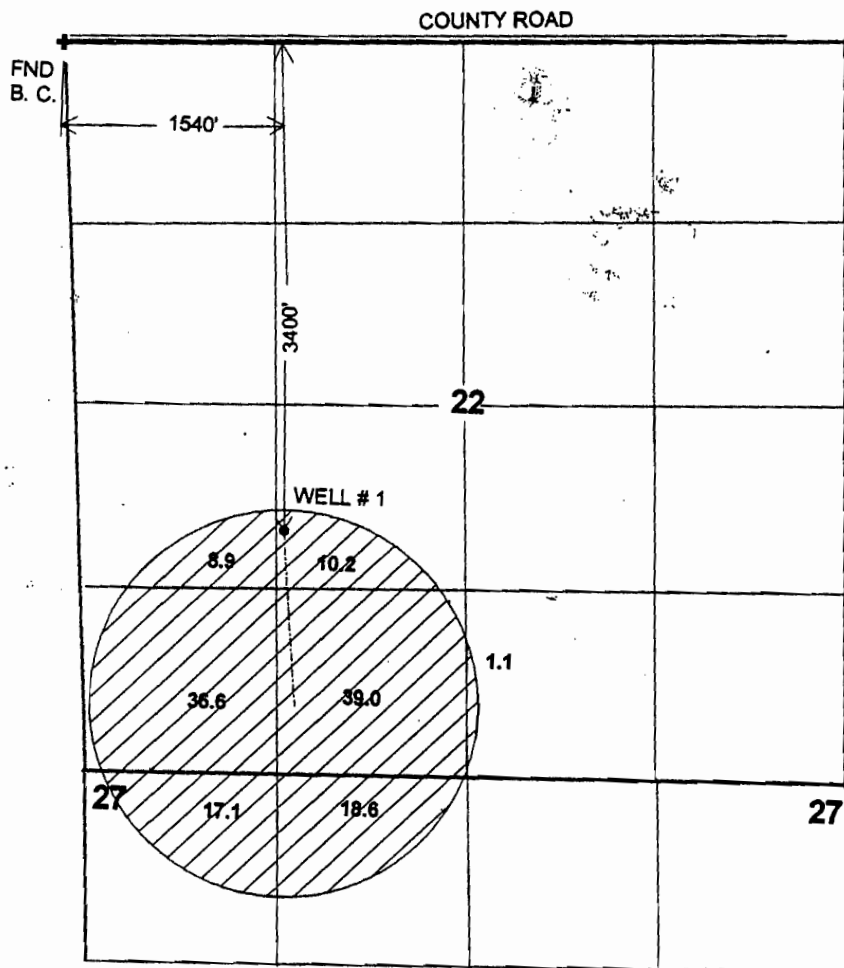

1" = 1320'

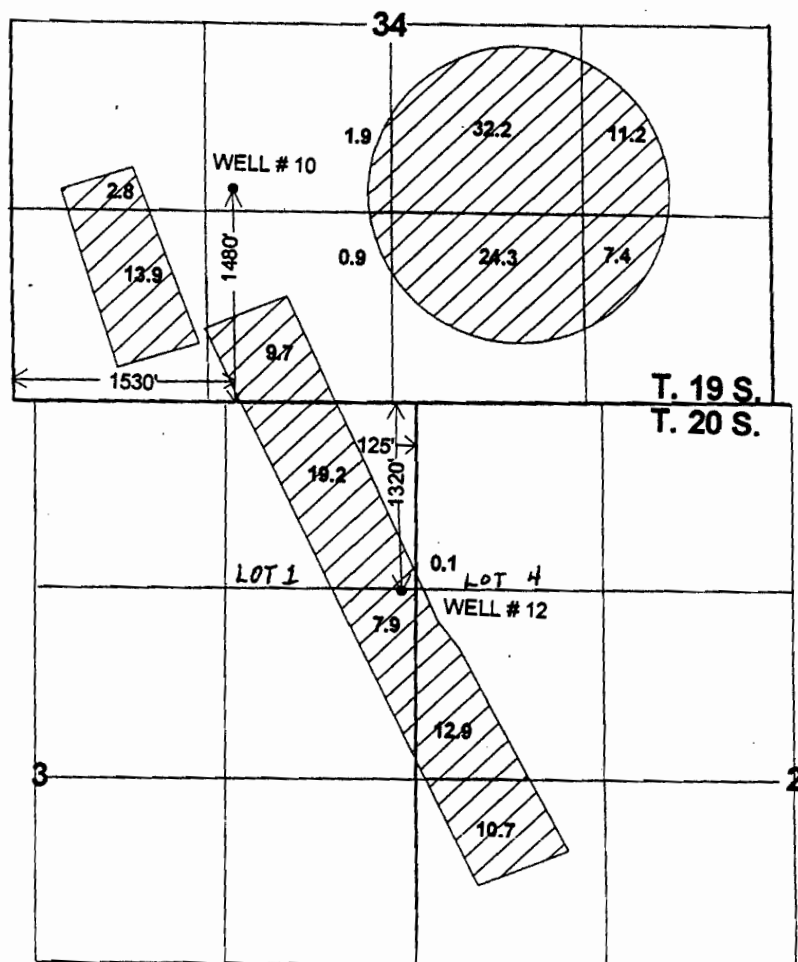

FINAL PROOF SURVEY UNDER

Application No. G-7664 Permit No. G-7152

IN THE NAME OF
CONNECTICUT GENERAL LIFE INSURANCE
AND
PROBERT FAMILY TRUST

Surveyed: April 9, 2003 by: J. Miller

RECEIVED

MAY 02 2003

WATER RESOURCES DEPT.
SALEM, OREGON

6/5/06 JWG

GPS & SID FILE 43117-G3 & H3 J.M. 4-23-2003