


T. 3 S., R. 9 W., W.M.

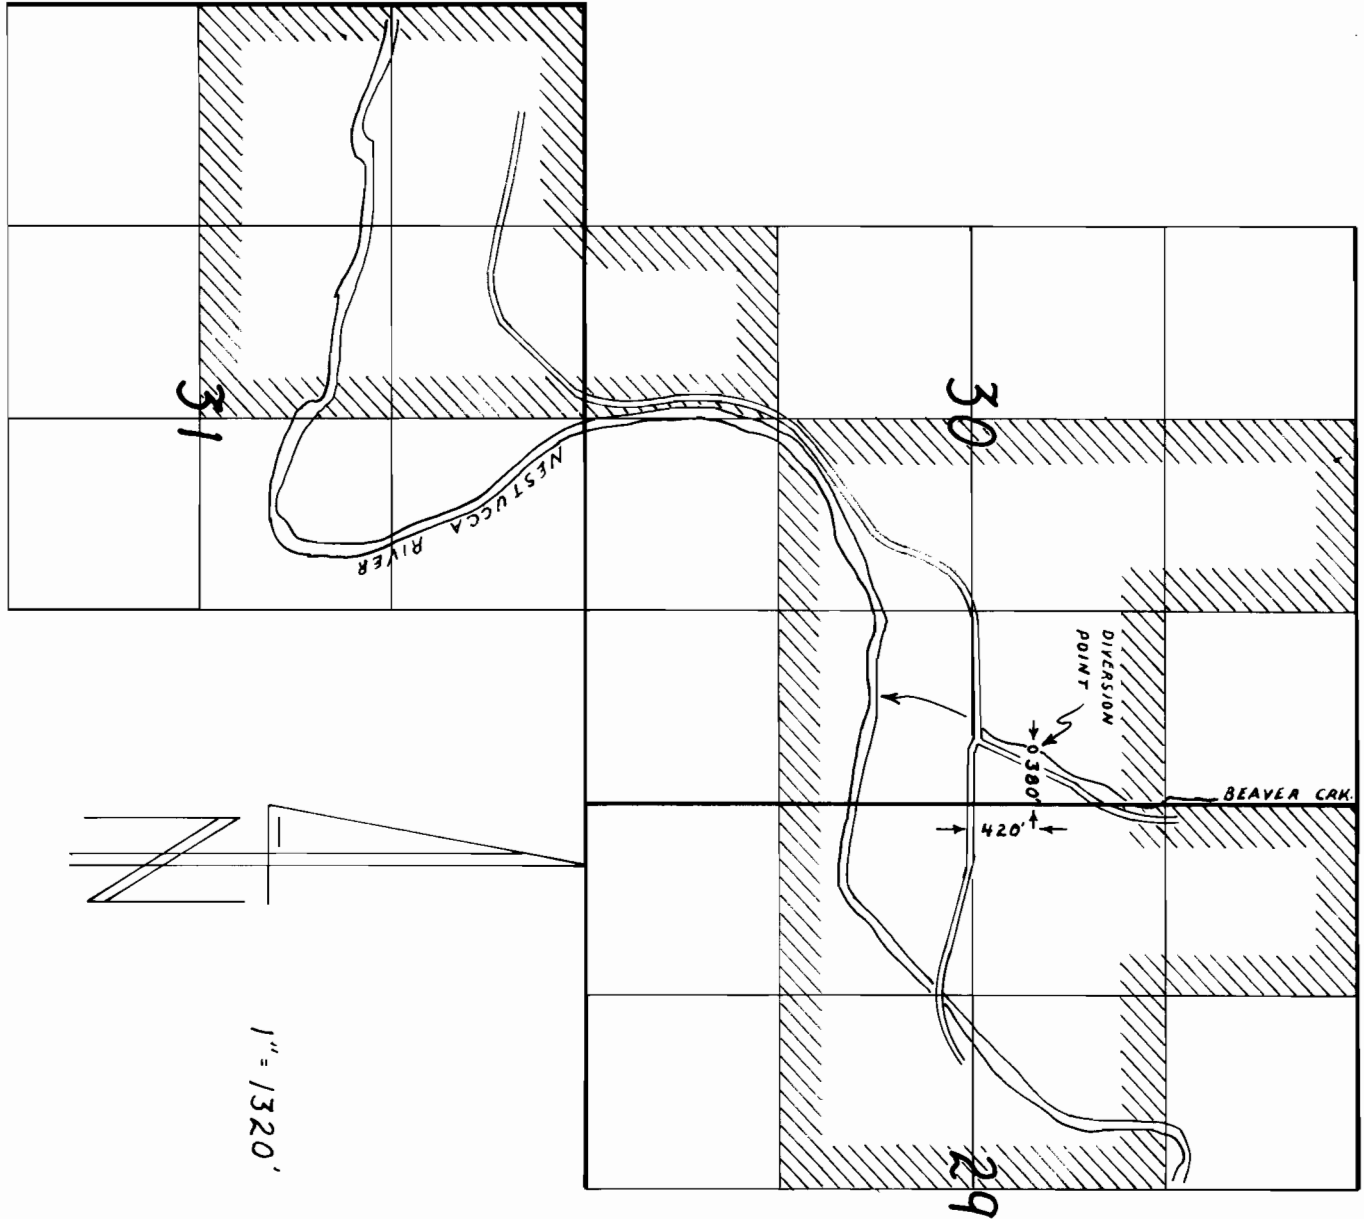

FINAL PROOF SURVEY

UNDER

Application No. 62964 Permit No. 46049

IN NAME OF

BEAVER WATER DISTRICT NO. 49

Surveyed July 21, 1993, by R.W. Klassen