


T. 11 S., R. 39 E., W.M.

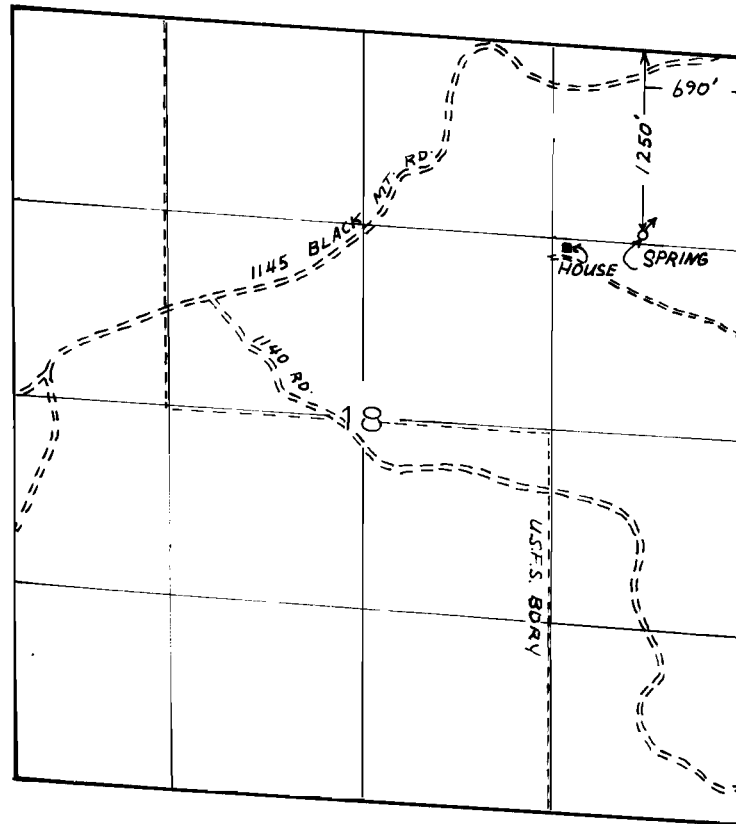

1" = 1320'

FINAL PROOF SURVEY

UNDER

Application No. 61630 Permit No. 45757
IN NAME OF

MICHAEL AND DEBORAH BROWN

Surveyed 5-8, 1992, by J. MILLER