
T. 25 S. R.34 E., W.M.

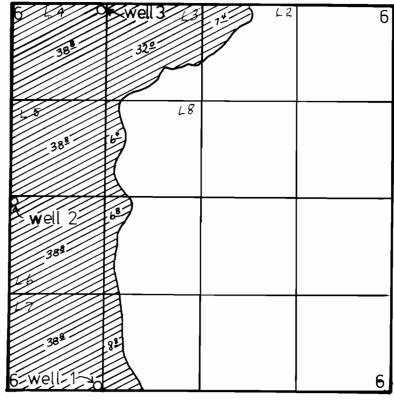

- Well # I 80 feet North and 1305 feet East from Southwest corner of Section 6
- Well # 2 2630 feet North and 30 feet East from Southwest corner of Section 6
- Well # 3 40 feet South and 1290 feet East from Northwest corner of Section 6, Township 25 S. Range 34 E., W.M.

FINAL PROOF SURVEY

RALPH OPIE
Surveyed 3-25 19.92 by J.MILLER

