


T. 26 S., R. 33 E., W.M.

APR 15 1993
PLAT 1993
RECORDED

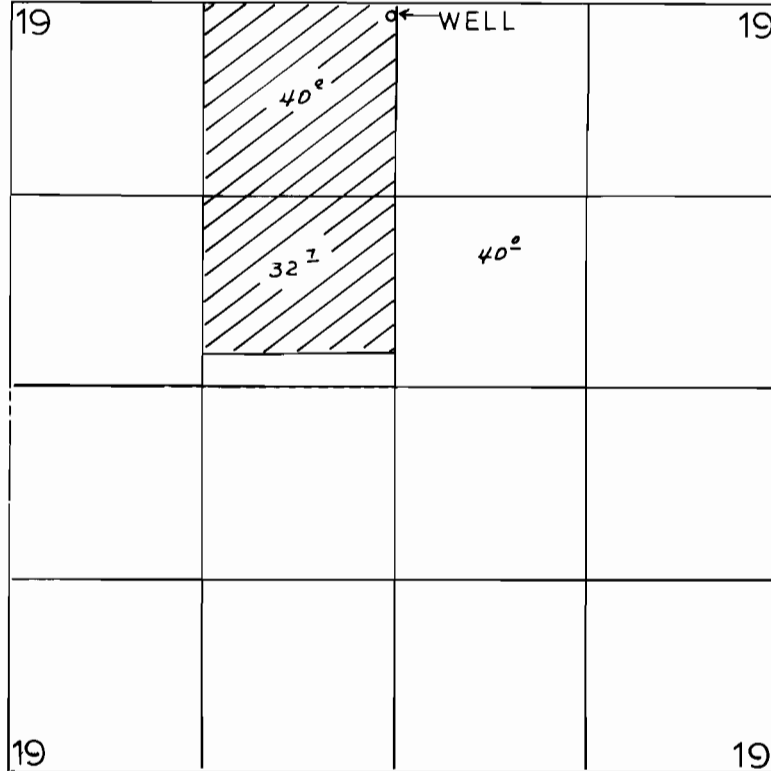

1" = 1320'

Well - 90' S. & 30' W. from the N 1/4 Corner of Section 19.

FINAL PROOF SURVEY

UNDER

Application No. G-10330 Permit No. G-9407
IN NAME OF

ROCKING L. RANCH, INC.

Surveyed AUGUST 6, 1993, by J. MILLER