


See File
S-58740
FOR MAP

151' 124'

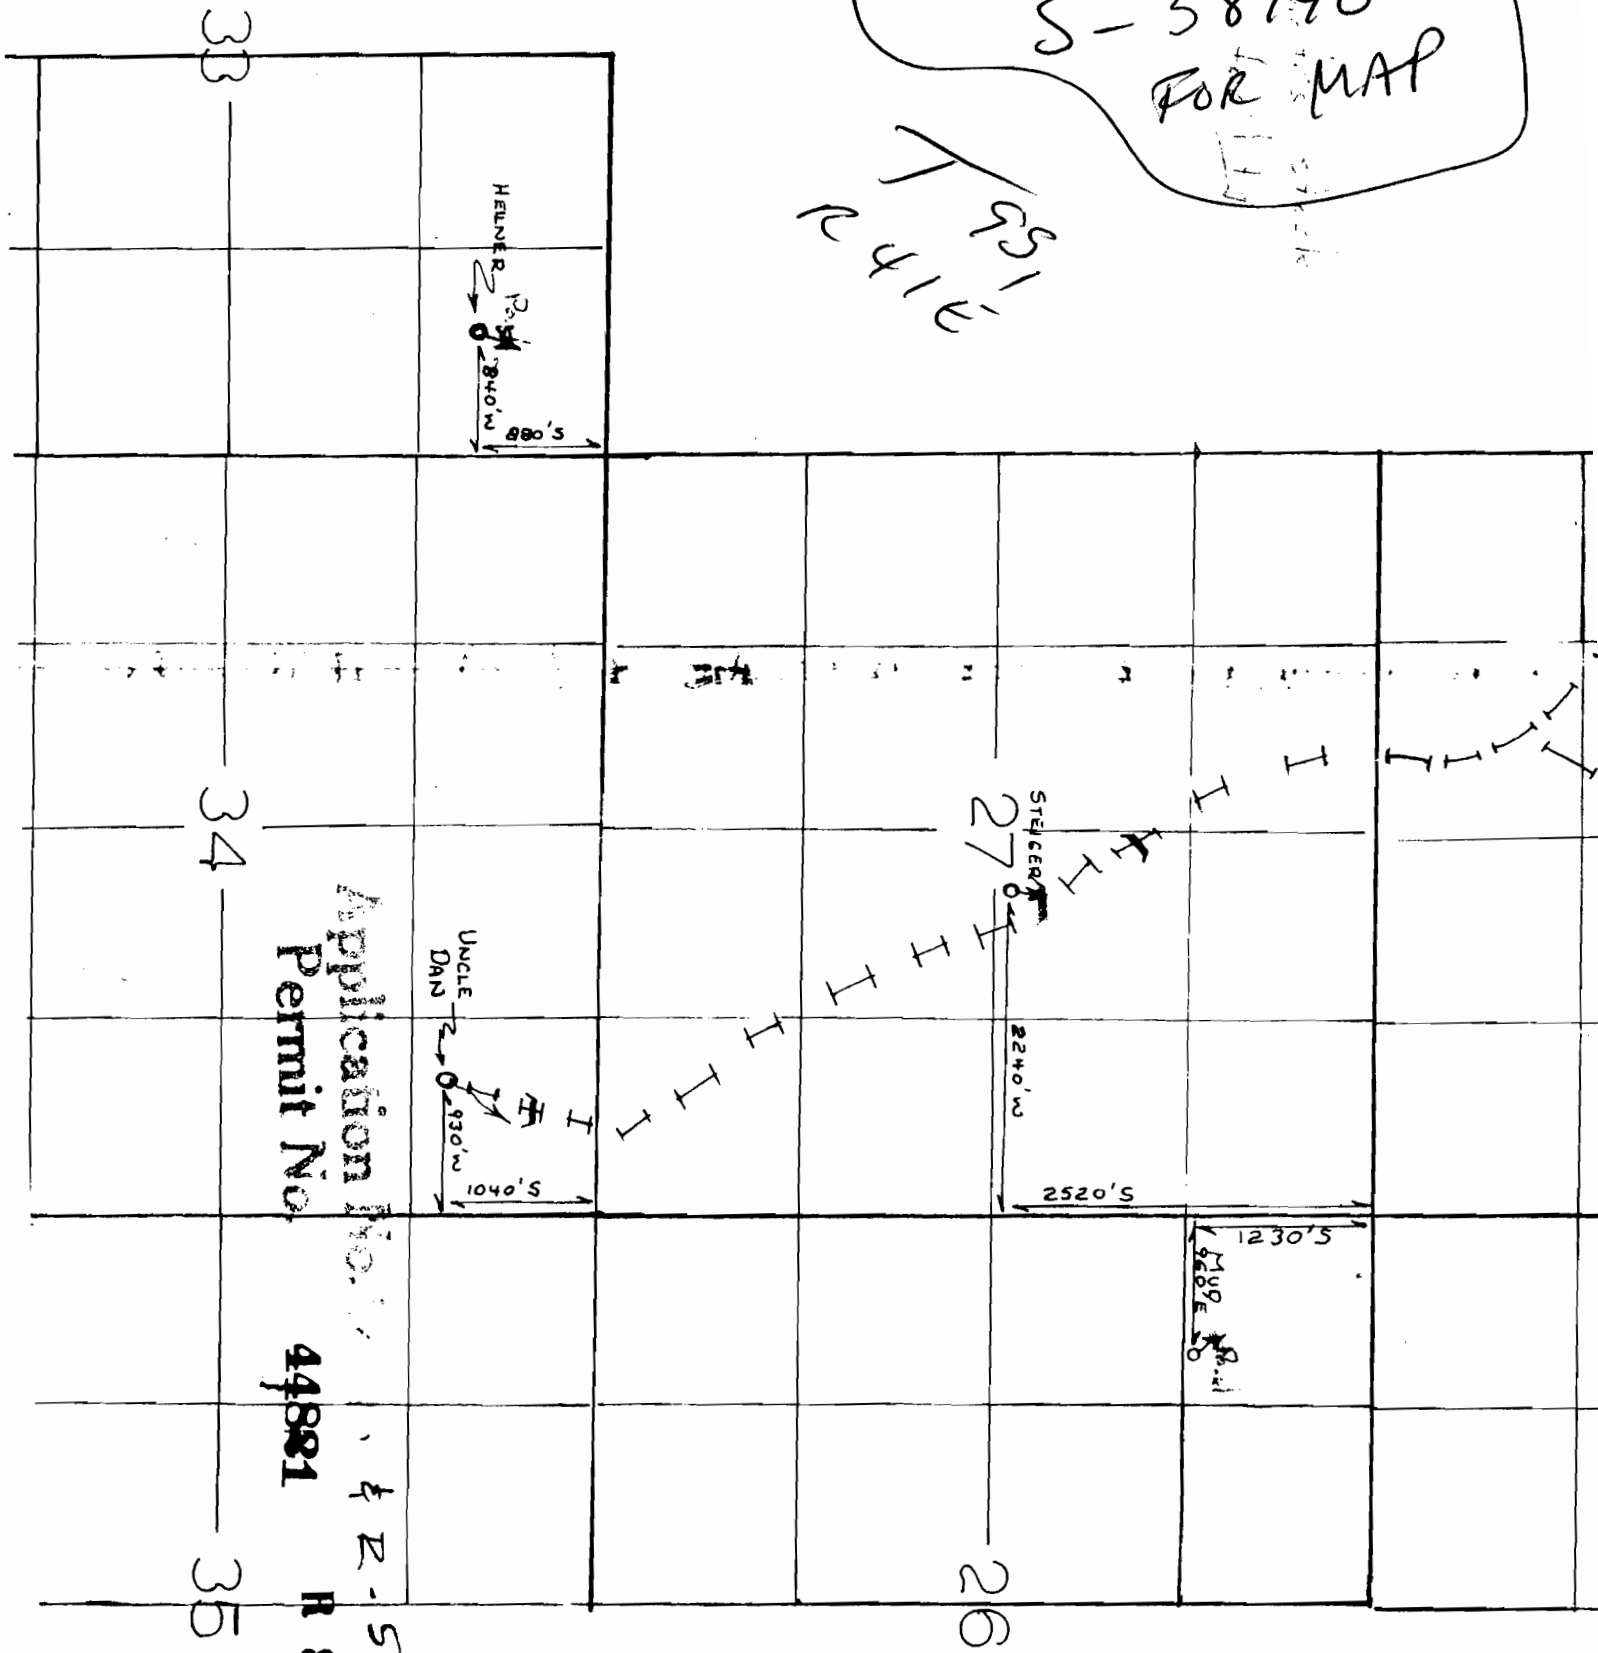

Application No. 44881
Permit No. 8124
R-59842