
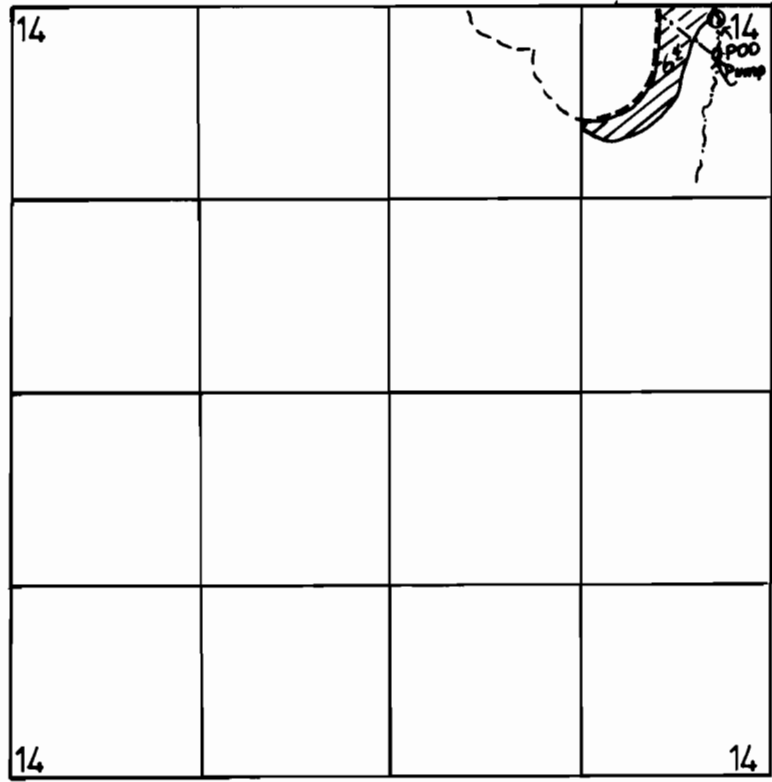


T. 9 S. R. 45 E., W.M.

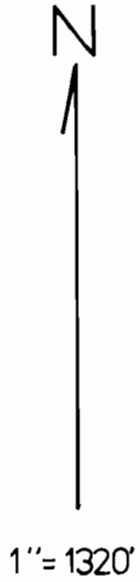

POD: 80' S & 360' W, NE COR, Sec 14

FINAL PROOF SURVEY UNDER

Application No. 60243. Permit No. 46530.....
IN NAME OF

.....WALTER S. SAUNDERS, JR.

Surveyed 7-19.... 1991., by J. MILLER.....