


T. 8 S., R 38. & 39 E., W. M.

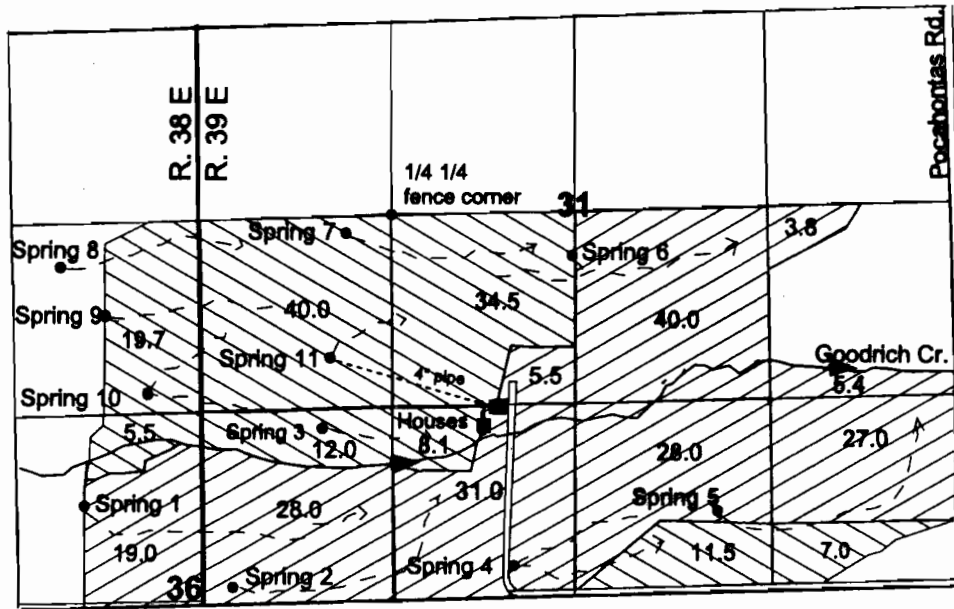

Primary Irrigation



Supp'l Irrigation.
Primary under C # 68123

LOCATION OF DIVERSIONS FROM SPRINGS

- Spring # 1 - 669' N. and 836' W. from the SE Corner of Section 36.
- Spring # 2 - 73' N. and 187' E. from the SW Corner of Section 31.
- Spring # 3 - 1175' N. and 826' E. from the SW Corner of Section 31.
- Spring # 4 - 196' N. and 2086' E. from the SW Corner of Section 31.
- Spring # 5 - 537' N. and 1677' W. from the SE Corner of Section 31.
- Spring # 6 - 305' S. and 22' W. from the Center Corner of Section 31.
- Spring # 7 - 77' S. and 1005' E. from the W. Corner of Section 31.
- Spring # 8 - 2315' N. and 986' W. from the SE Corner of Section 36.
- Spring # 9 - 1971' N. and 660' W. from the SE Corner of Section 36.
- Spring # 10 - 1443' N. and 405' W. from the SE Corner of Section 36.
- Spring # 11 - 937' S. and 860' E. from the W. Corner of Section 31.

FINAL PROOF SURVEY UNDER

Application No. 51989 Permit No. 39167

IN THE NAME OF
HARRELL LAND AND CATTLE L.L.C.
Surveyed 10-04-2001, by J. Miller