


T. 19 S., R. 43 E., W.M.

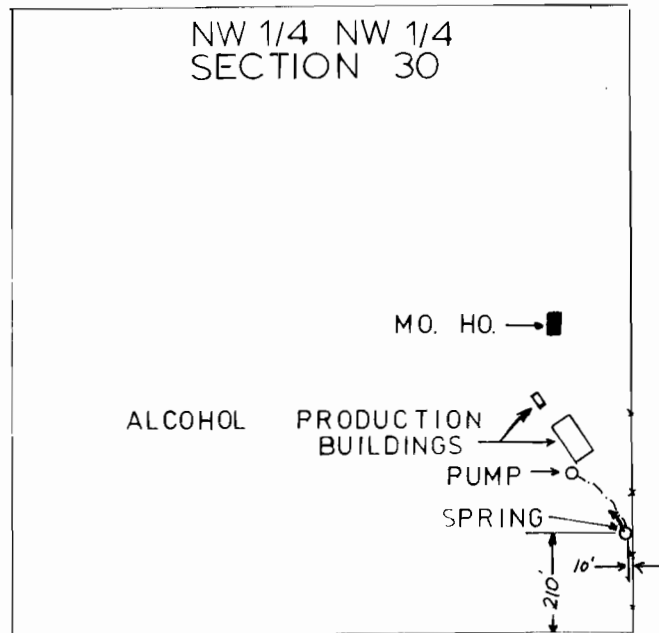

FINAL PROOF SURVEY UNDER

Application No. 59788 Permit No. 45220
IN NAME OF

9 - MILE FARMS INC.

Surveyed 8-26, 1993, by J. MILLER