


T. 15 S., R. 42 E., W.M.

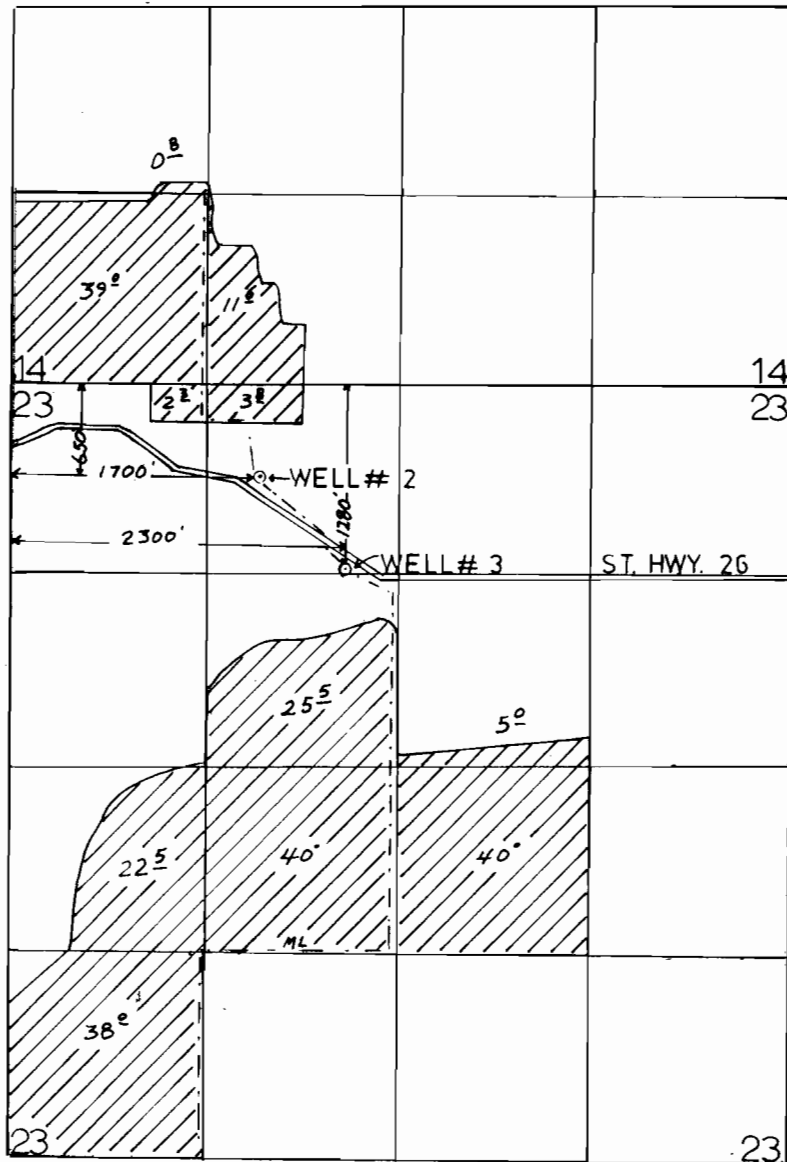

1" = 1320'

FINAL PROOF SURVEY

UNDER

Application No. G-10381 Permit No. G-9458
IN NAME OF

CRAIG SIDDOWAY

Surveyed 8-13, 1993, by J. MILLER