


T.27 S.R.17 E.W.M.

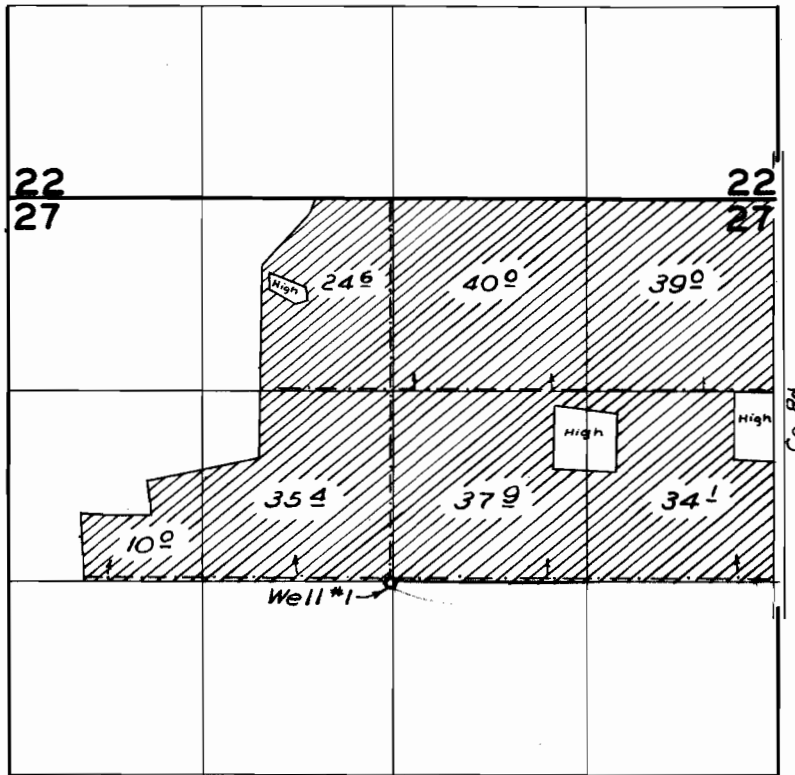

FINAL PROOF SURVEY UNDER

Application No. U-469 Permit No. U-487
IN NAME OF

CENTURY RANCH

Surveyed 15 May 1959, by Jm. Bish