


T.4S., R.11E., W.M.

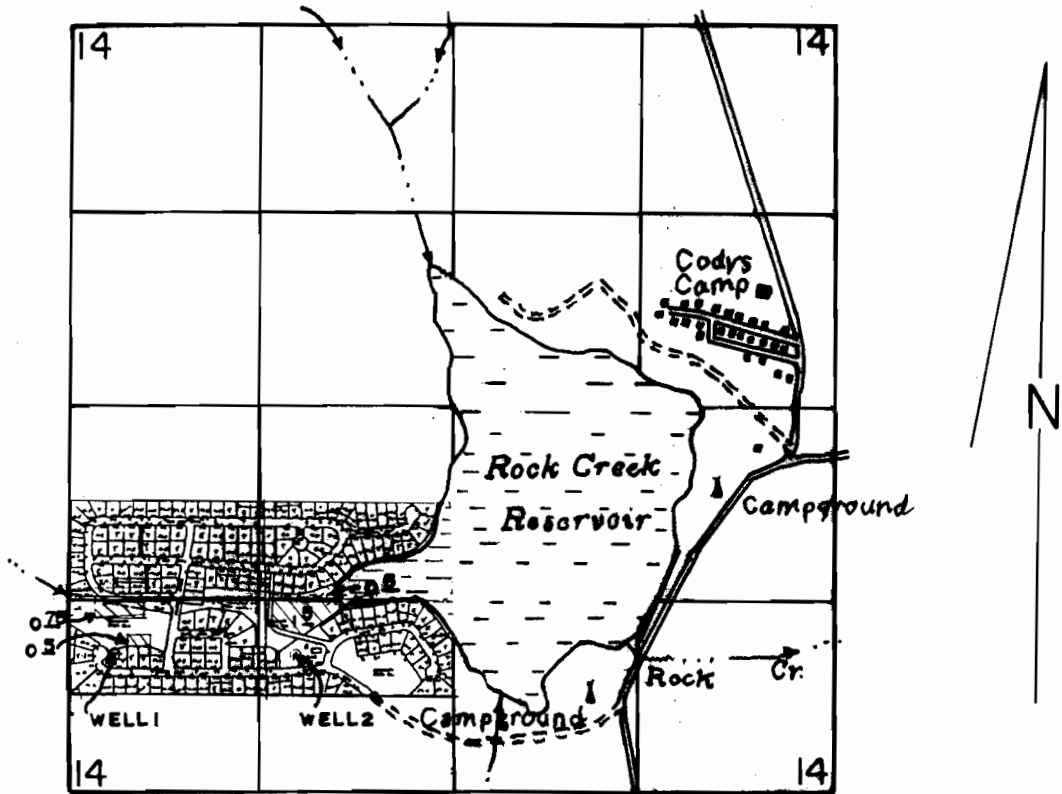

WELL 1, LOC: 380'S & 310'E FROM S 1/16 COR. OF SEC 14.
WELL 2, LOC: 390' & 1530' E FROM S 1/16 COR. OF SEC 14.
IRRIGATION OF 3.0 AC. & DOMESTIC USE FOR 142 FAMILIES.

SCALE: 1" = 1320'

FINAL PROOF SURVEY UNDER

Application No. G-11274 Permit No. G-10453.
IN NAME OF

SPORTSMANS PARK WATER ASSN.

Surveyed JUNE 28 1995, by R.M. SHUTTERFIELD