


T. 18 S., R. 40 E., W.M.

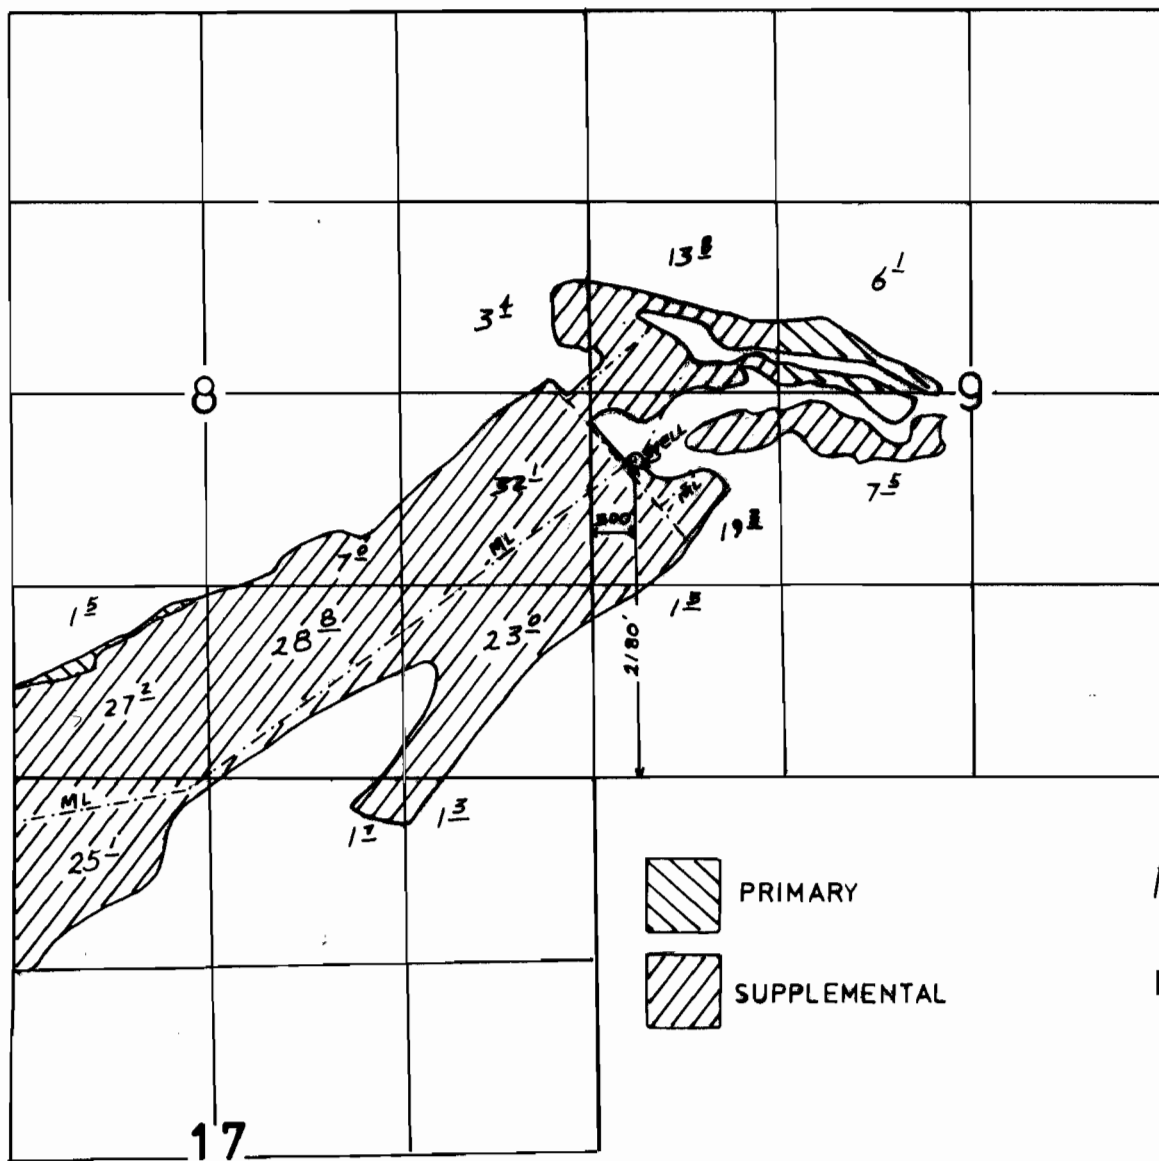

FINAL PROOF SURVEY

UNDER

1" = 1320'

Application No. G-8955 Permit No. G-8358
IN NAME OF

Surveyed 12-4, 1990, by K. KEMP