


T.30S. R.46E., W.M.

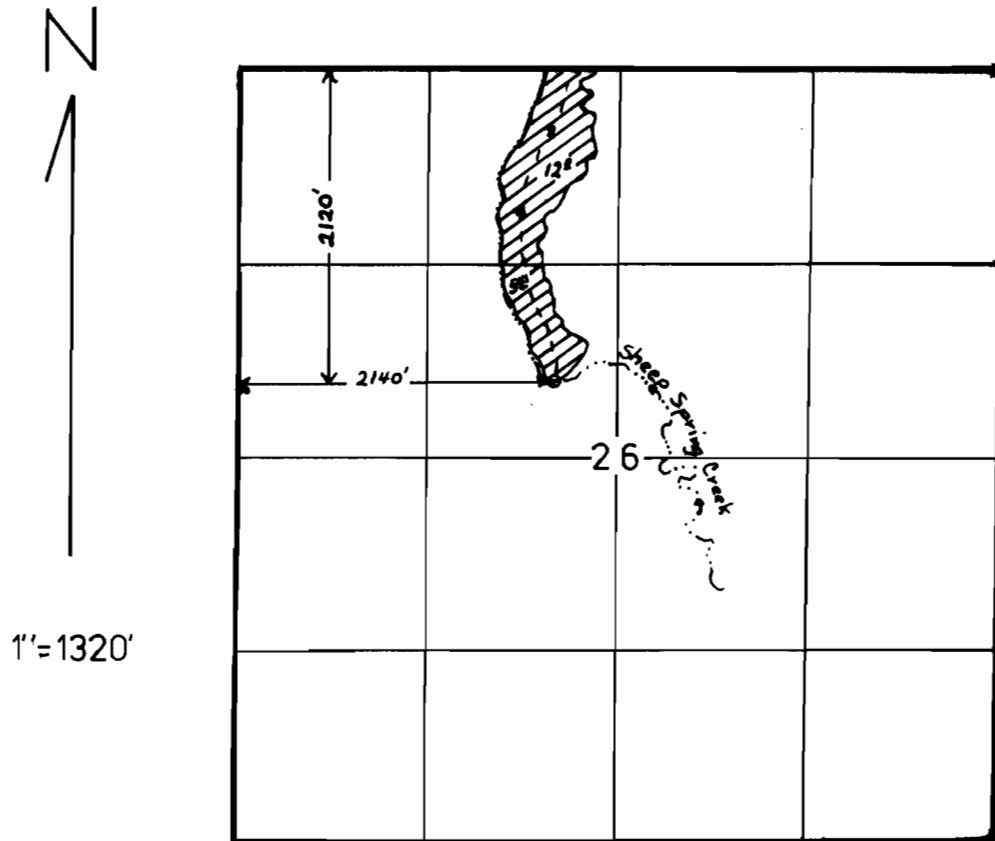

FINAL PROOF SURVEY
UNDER

Application No. 51803... Permit No. 39022.....
IN NAME OF

.....RICHARD G. SKINNER.....

Surveyed ..3-26... 1992., by J. MILLER.....