



T. 14 & 15 S., R. 15 & 16 E., W.M.

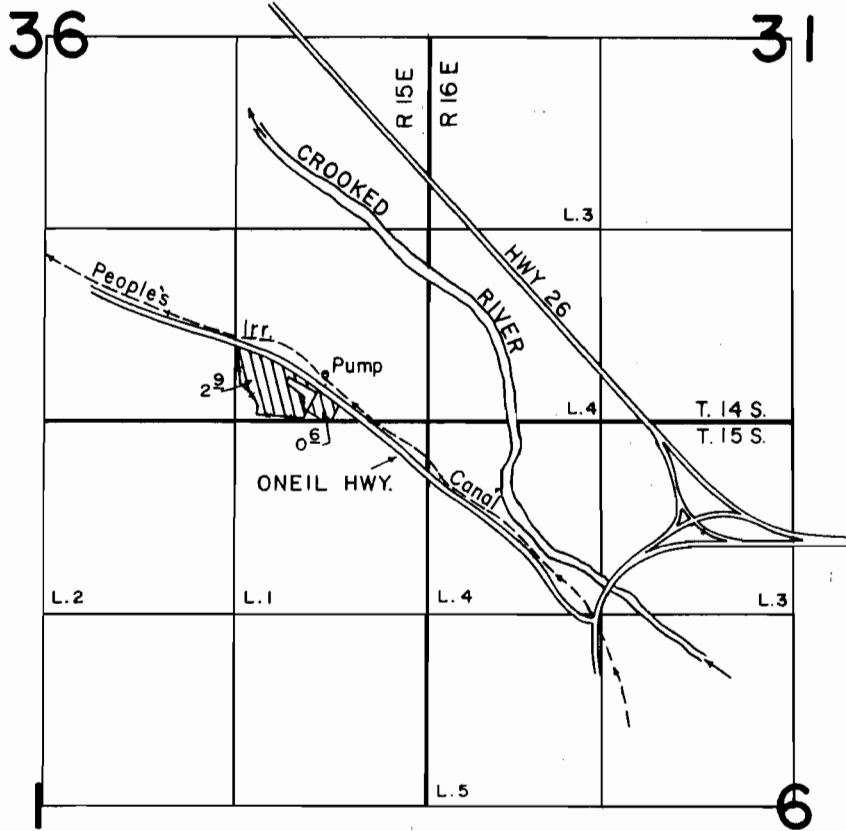

T. 15 S., R. 16 E., W.M.

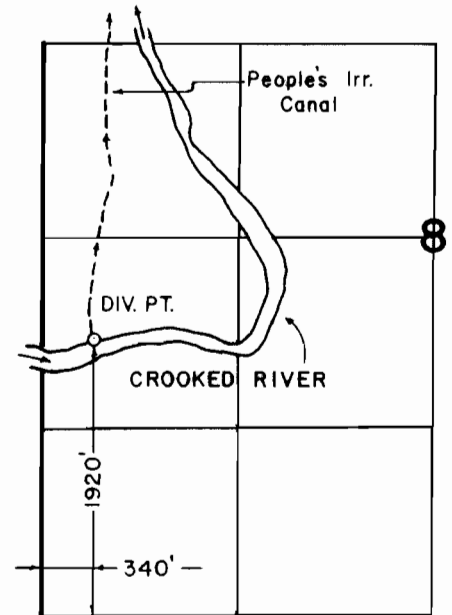

SCALE: 1" = 1320'

FINAL PROOF SURVEY
UNDER

Application No. 68758... Permit No. 49890.....

IN NAME OF

H. WAYNE KEE

Surveyed FEB. 6... 1990, by B. W. BISHOP.....

4-5-90
PTS