


# T. 19 S., R 42 E., W. M.

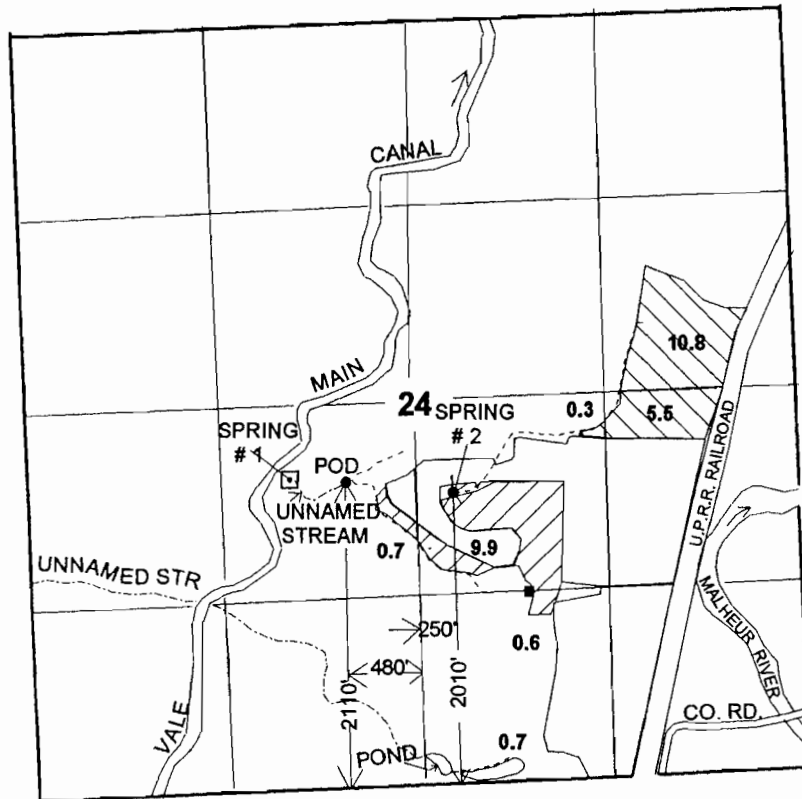

## FINAL PROOF SURVEY

UNDER

Application No. 67323 Permit No. 48991

IN THE NAME OF

**HAKEN ANDERSON**

Surveyed: April 10, 2003 By: J. Miller

**RECEIVED**

MAY 02 2003

WATER RESOURCES DEPT.  
SALEM, OREGON