


T. 20 S., R. 42 E., W.M.

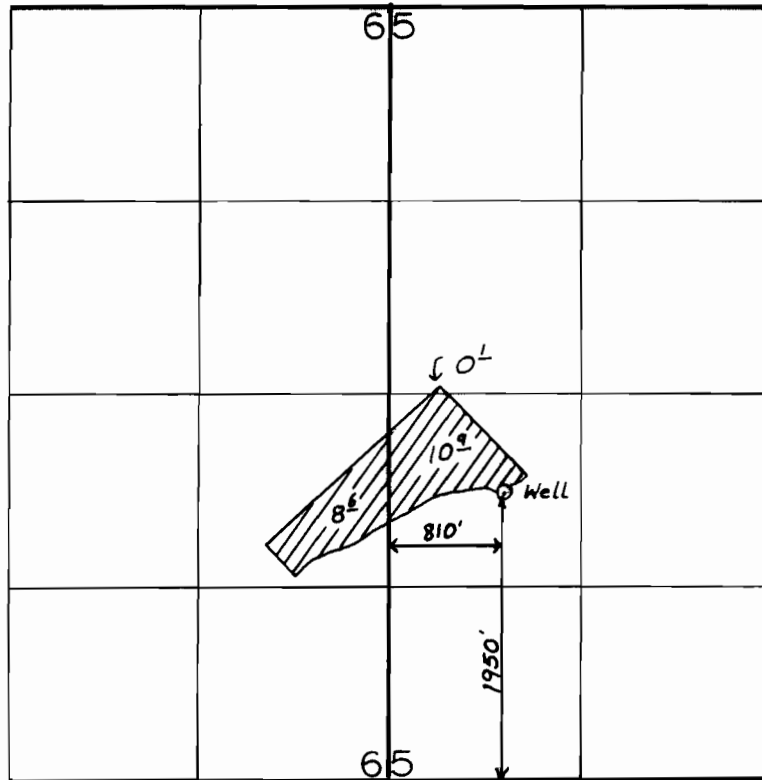

1" = 1320'

FINAL PROOF SURVEY

UNDER

Application No. G-11012 Permit No. G-10182
IN NAME OF

JOHN DAWSON

Surveyed 6-11, 1990, by K. RISE