


TOWNSHIP 9 SOUTH, RANGE 38 EAST, W.M.

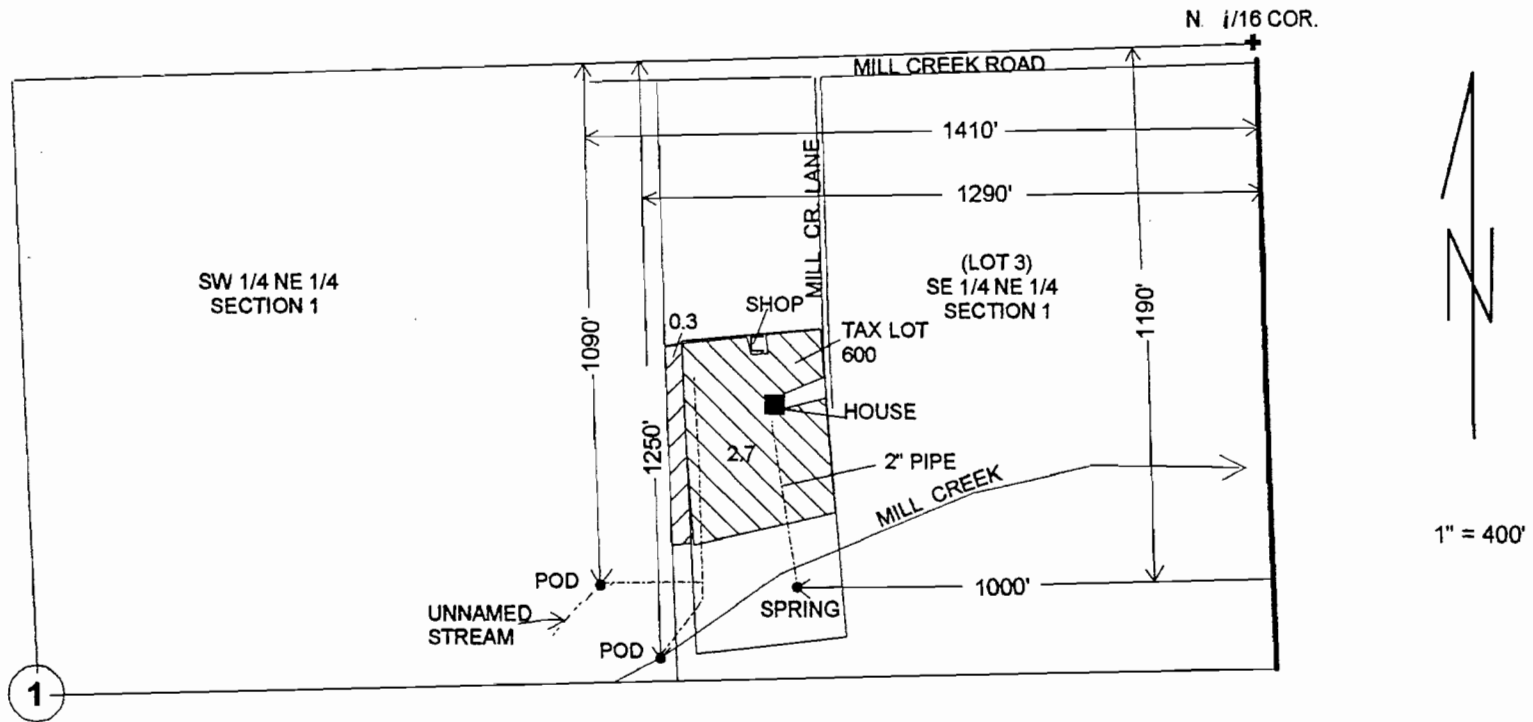

FINAL PROOF SURVEY

UNDER

Application No. 68879 Permit No. 50005

IN THE NAME OF

Surveyed: September 12, 2001 by: J. Miller

RECEIVED

MAR 03 2003

WATER RESOURCES DEPT.
SALEM, OREGON

6/7/06 JWG

TAX LOT MAP & AERIAL NAPP 2026 JM 2-13-2003