


T. 19S., R. 43E., W.M.

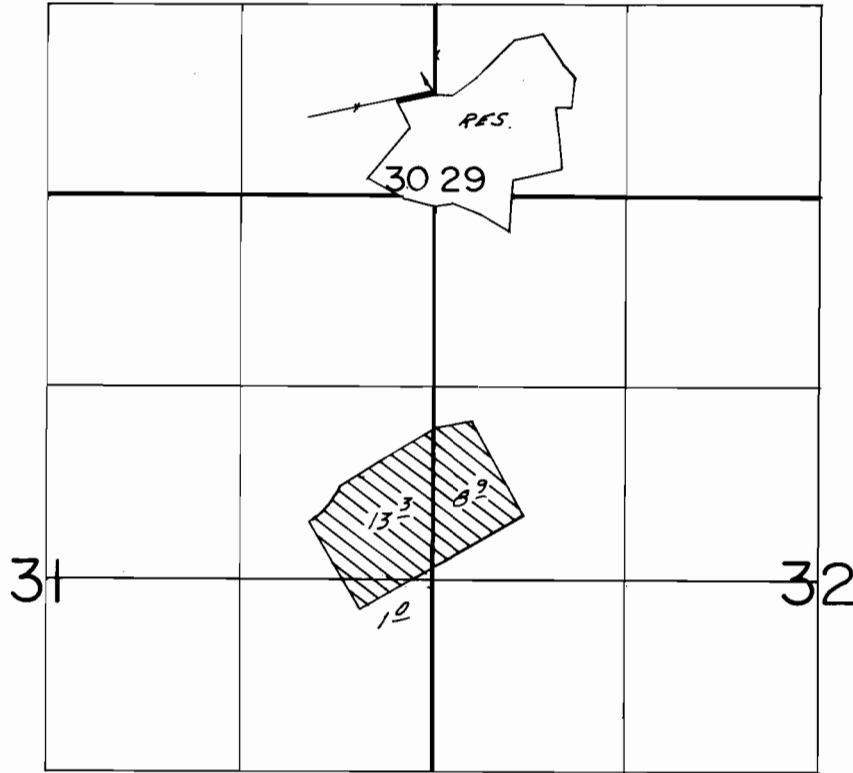

SCALE: 1" = 1320'

FINAL PROOF SURVEY
UNDER

Transfer No. 4817
Application No. R-51848 Permit No. R-6744
IN NAME OF

.....LAVERN & OPAL EASTERDAY.....

Surveyed May 8..... 1986, by L.M. TOLL.....

PTS 1986V-A
41045-178-71R

3/20/87
JTB