


***T. 4 N., R. 32 E., W.M.***

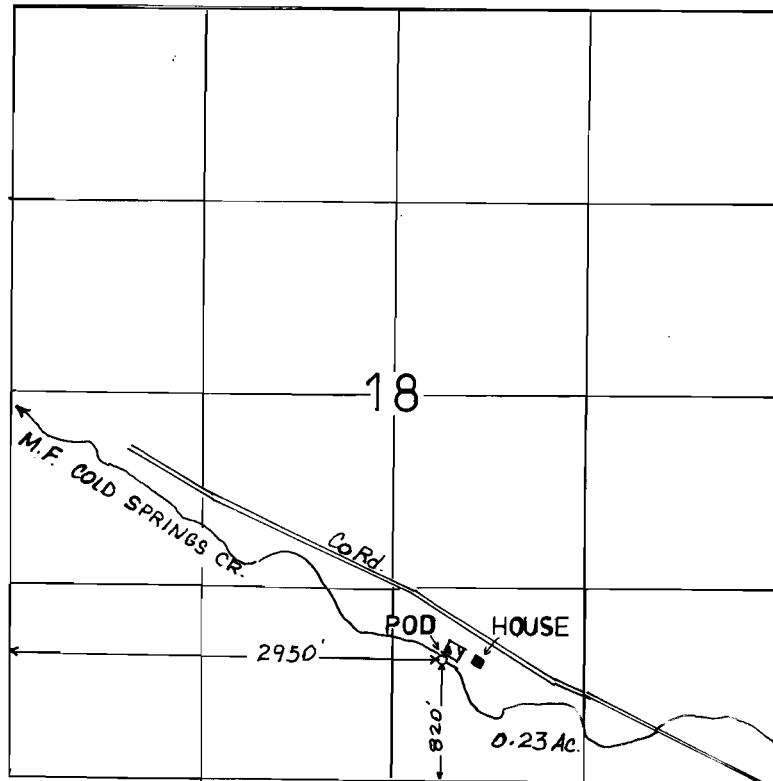

1" = 1320'

***FINAL PROOF SURVEY***  
UNDER

Application No. 41642 Permit No. 30748  
IN NAME OF

***JOHN W. AND GERALDINE SPRINGSTEEN***

Surveyed JANUARY 25, 1994, by J. Miller