



T. 28 S., R. 5 W., W. M.

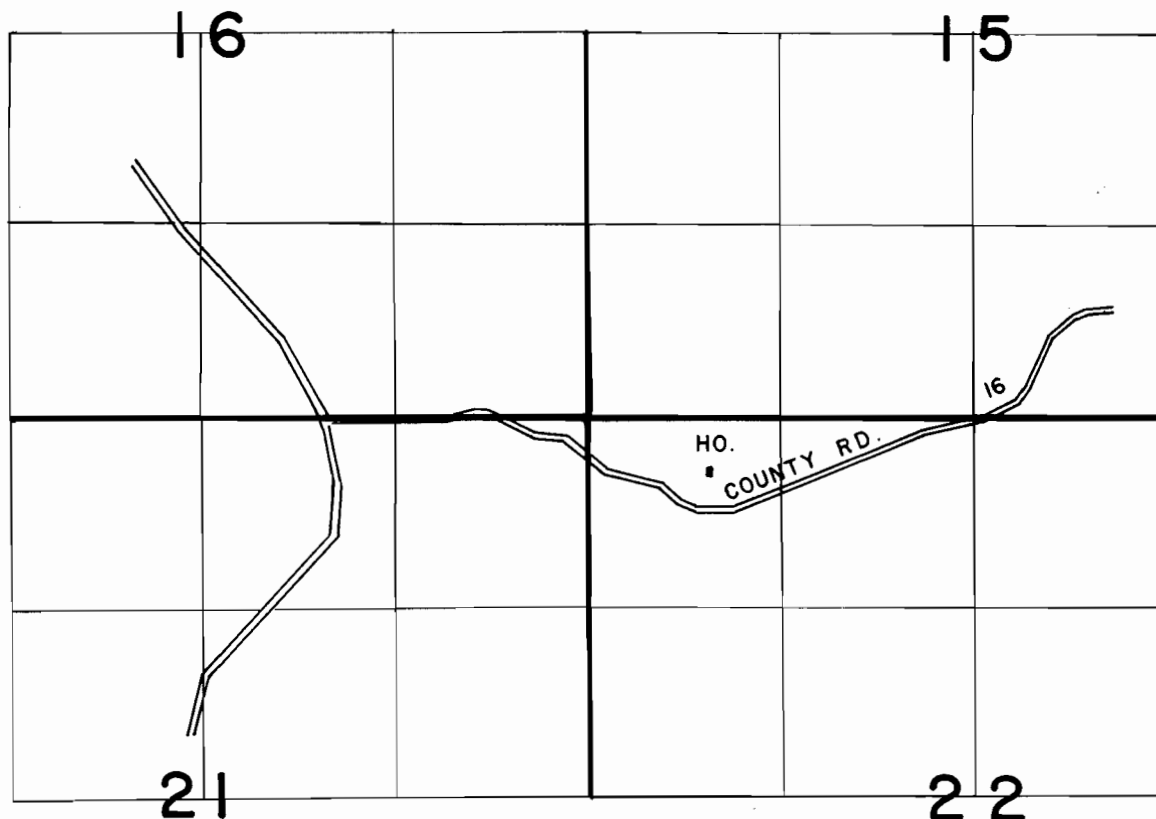

SCALE: 4" = 1 MILE

FINAL PROOF SURVEY
UNDER

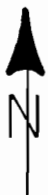

TRANSFER NUMBER: T-5658
IN NAME OF

MELVIN B. HARRIS

Surveyed AUG. 10. 1988, by J.M. SCHMORDE