


T. 1 N., R. 3 E., W.M.

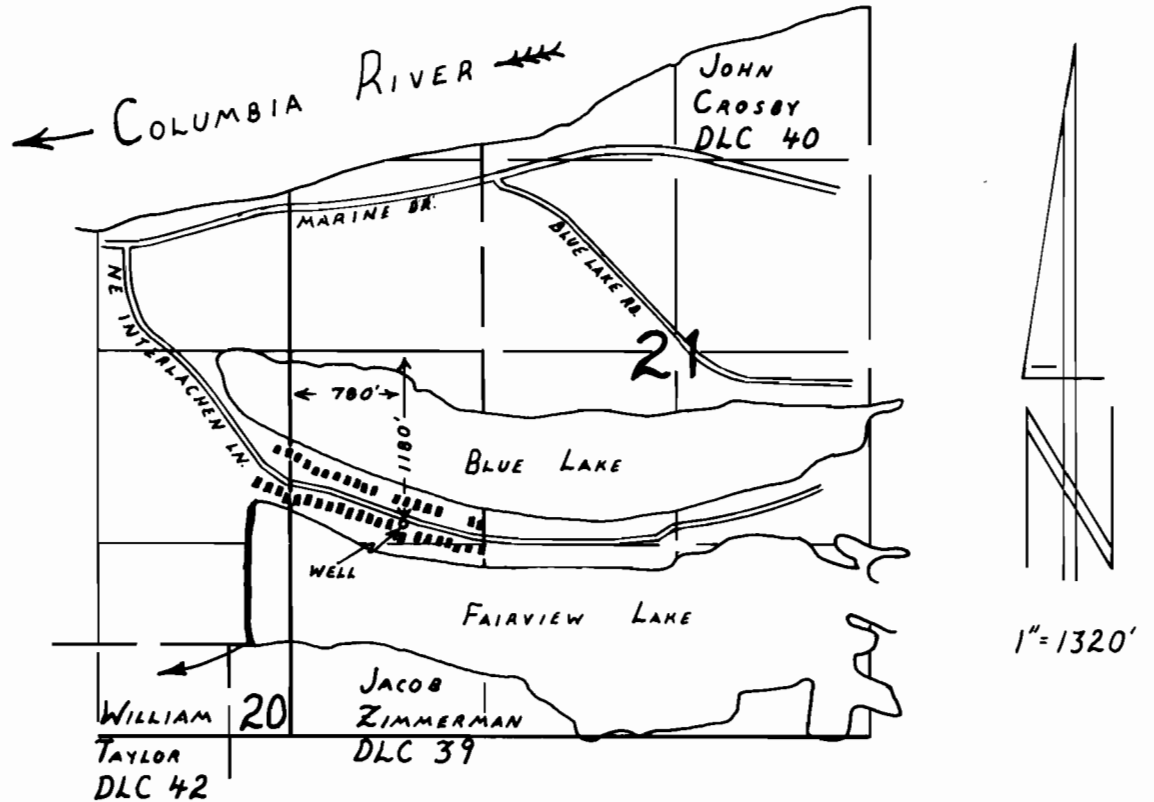

FINAL PROOF SURVEY

UNDER

Application No. G-4114 Permit No. G-3862
IN NAME OF

West Interlachen Water Co-op, Inc.

Surveyed August 17, 1993, by R.W. Klassen