
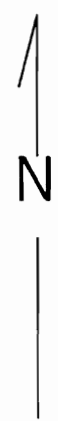


T.4S., R.5 W., W.M.

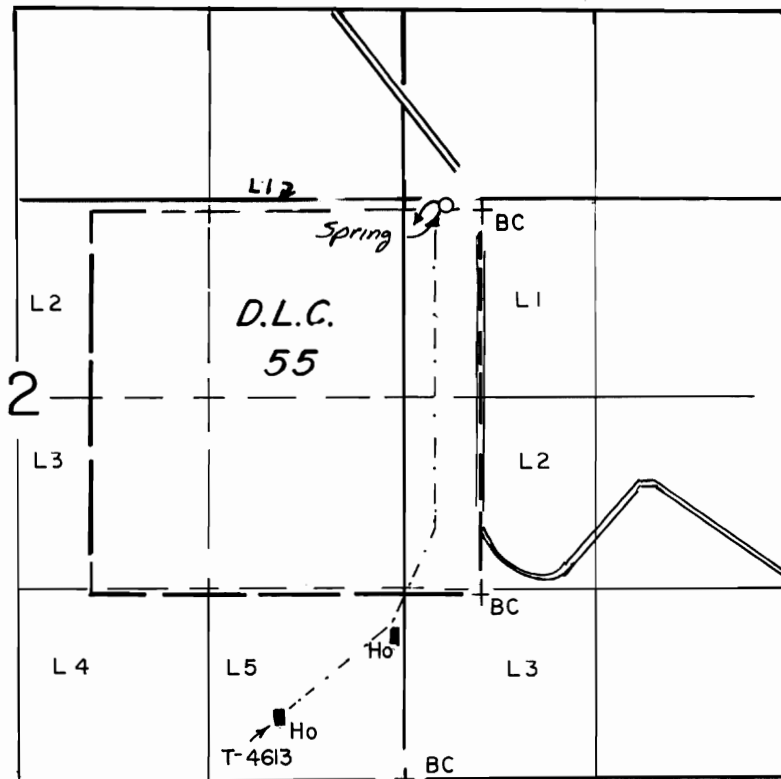

SPRING LOC: 30' N. & 240' W. FROM N.E. COR. D.L.C. 55

SCALE: 1" = 1320'

FINAL PROOF SURVEY UNDER

TRANSFER NO. 4613

Application No. ~~60859~~..... Permit No. ~~49918~~.....
IN NAME OF

MAX E MORROW

Surveyed OCT 4..... 1983., by P. PAGTER.....
SEPT 14 87 B W BISHOP