


T.27S.,R.16E.,W.M.

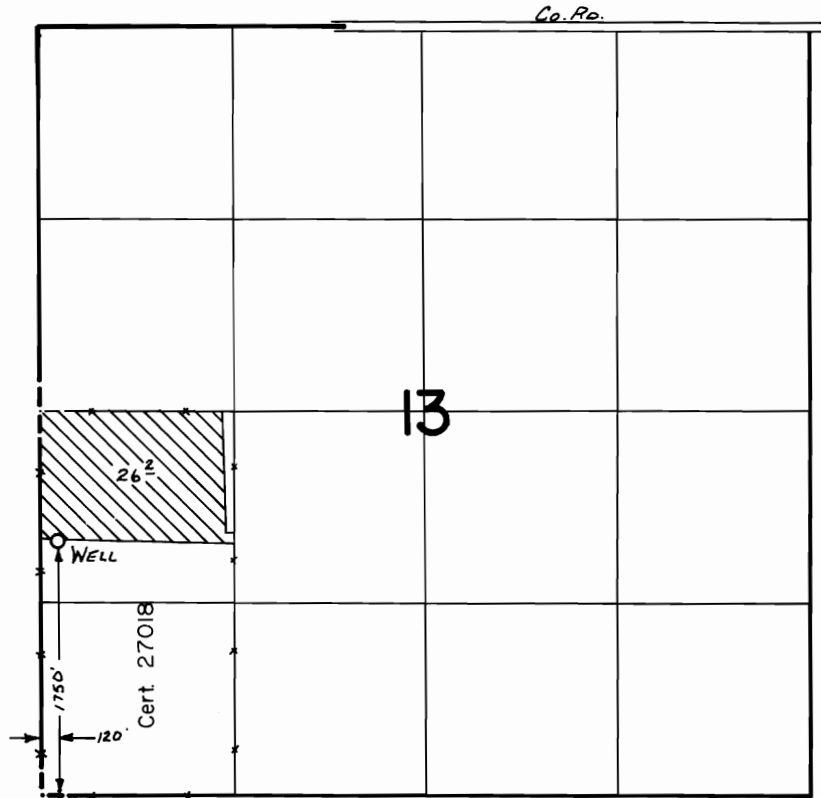

FINAL PROOF SURVEY
UNDER

Application No. G-1023. Permit No. G-9264.....
IN NAME OF

.....**ERNEST P. TUCKER**.....

Surveyed July..23... 19.83., by ...L.M.TOLL.....