90684

T. 4S., R. 5 W., W.M.

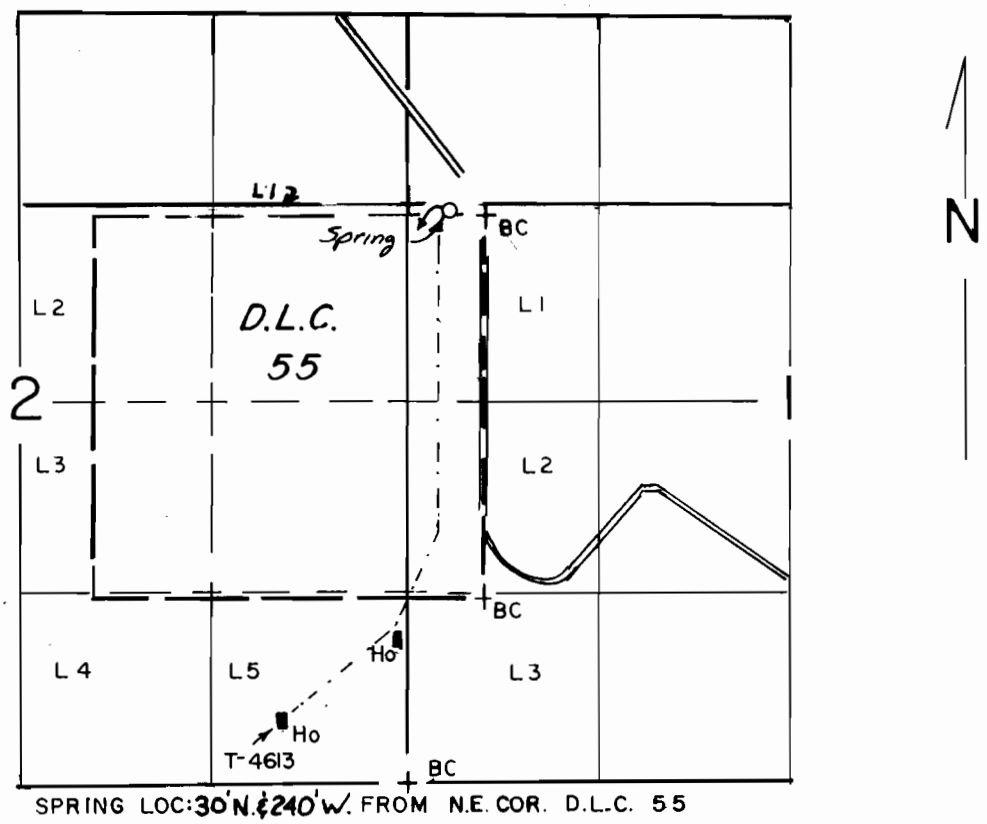

SCALE: 1" = 1320'

FINAL PROOF SURVEY

UNDER

TRANSFER NO. 4613

Application No. 60859 Permit No. 49918

IN NAME OF

MAX E MORROW

Surveyed OCT 4 19 83, by P. PAGTER
SEPT 14 87 B W BISHOP

DFQ-1LL-71 PT31983AA