


T.1S. R.4W. W.M.

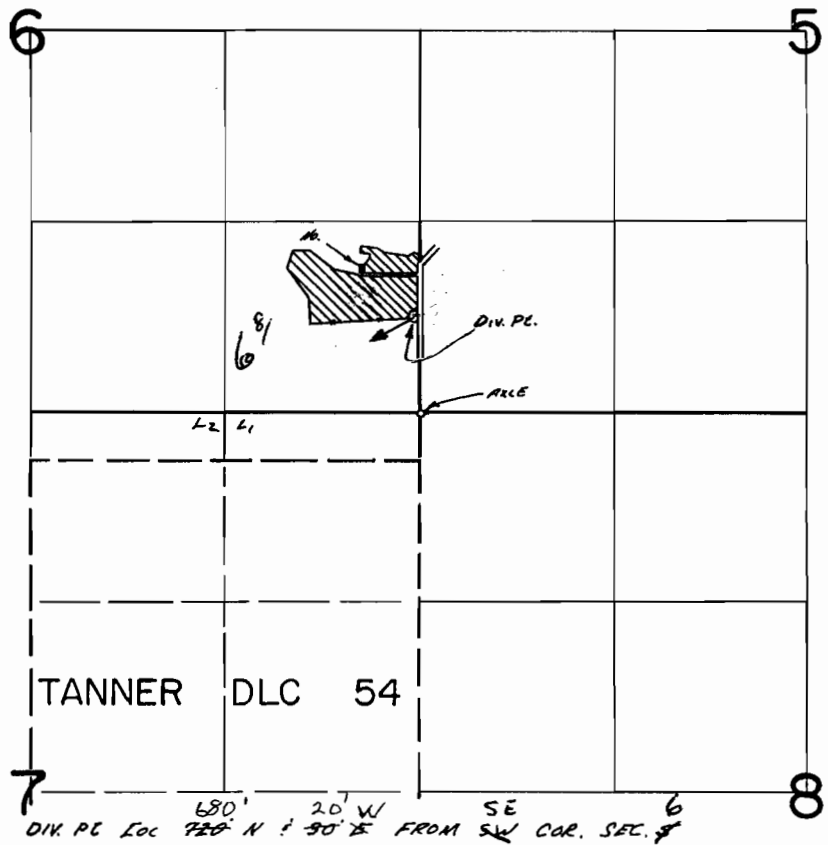

FINAL PROOF SURVEY
UNDER

Transfer No. ⁵⁷⁴⁵ ~~2588~~
 Application No. Permit No.
 IN NAME OF

ROLLO L. KINTZ

7/29/88 T M WARREN
 Surveyed Oct. 2, 1974, by R. G. MUCKEN