


T. 2 N., R. 32 E., W.M.

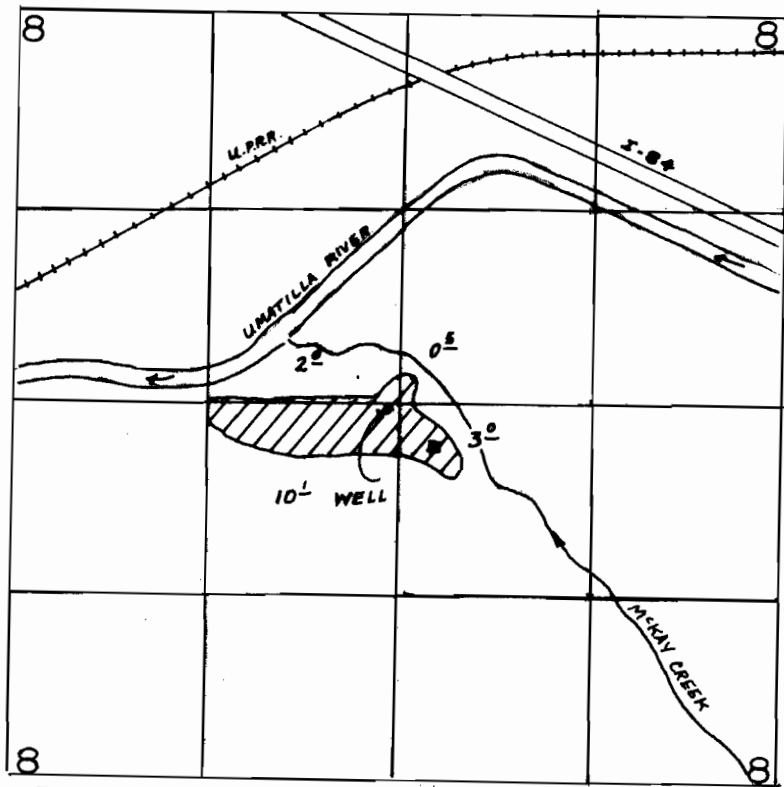

WELL - 50' S. AND 80' W. FROM THE CEN. COR. SEC. 8

FINAL PROOF SURVEY

UNDER

Application No. G-11403 Permit No. G-10510
IN NAME OF

DONALD AND VALOYCE WRIGHTSON

Surveyed 7-24, 1922, by J. MILLER